


15-007-20330-0000

STATE OF KANSAS
STATE CORPORATION COMMISSION
CONSERVATION DIVISION
P. O. BOX 17027
WICHITA, KANSAS 67217

FORM CP-4

WELL PLUGGING RECORD

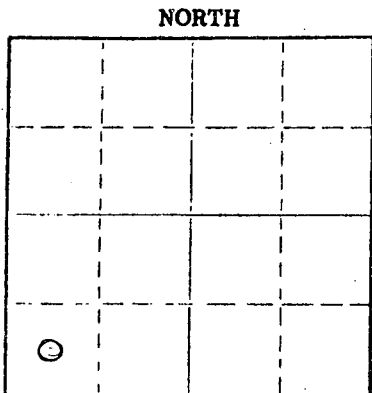

Locate well correctly on above Section Plat

Barber County. Sec. 26 Twp. 31S Rgc. (E) 14W (W)
Location as "NE/CNW4SW4" or footage from lines SW SW
Lease Owner Mahoney Drilling Company
Lease Name Mills Feed, Land, & Cattle Well No. D-1
Office Address 901 Petroleum Building, Tulsa, Oklahoma 74103
Character of Well (completed as Oil, Gas or Dry Hole) Dry Hole
Date well completed July 9 1975
Application for plugging filed July 9 1975
Application for plugging approved July 9 1975
Plugging commenced July 9 1975
Plugging completed July 9 1975
Reason for abandonment of well or producing formation Dry Hole

If a producing well is abandoned, date of last production None 19
Was permission obtained from the Conservation Division or its agents before plugging was commenced? Yes

Name of Conservation Agent who supervised plugging of this well Russel Beaverstein
Producing formation None Depth to top Bottom Total Depth of Well 4750
Show depth and thickness of all water, oil and gas formations.

OIL, GAS OR WATER RECORDS

CASING RECORD

FORMATION	CONTENT	FROM	TO	SIZE	PUT IN	FULLED OUT
		0	331	8 5/8	323	None

Describe in detail the manner in which the well was plugged, indicating where the mud fluid was placed and the method or methods used in introducing it into the hole. If cement or other plugs were used, state the character of same and depth placed, from feet to feet for each plug set.

Plugged: 35 sacks @ 250, Bridge 15 sacks @ 40 ft. to base of cellar.

Completed: 3:00 PM 7-9-75

By: Halliburton


(If additional description is necessary, use BACK of this sheet)

Name of Plugging Contractor DaMac Drilling Company, Inc.
Address Box 1164, Great Bend, Kansas 67530

STATE OF Kansas COUNTY OF Barton ss.

Martha J. McKown

(employee of owner) or (owner or operator) of the above-described well, being first duly sworn on oath, says: That I have knowledge of the facts, statements, and matters herein contained and the log of the above-described well as filed and that the same are true and correct. So help me God.

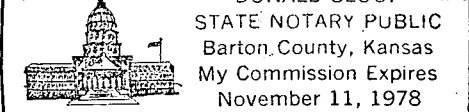

(Signature) Martha J. McKown

Box 1164, Great Bend, Kansas

(Address)

Subscribed and sworn to before me this 14th day of July, 1975

Donald Sloup

Notary Public.

My commission expires Nov. 11, 1978

RECEIVED
STATE CORPORATION COMMISSION

JUL 16 1975
7-16-75
CONSERVATION DIVISION
Wichita, Kansas

15-007-20330-0000

WELL LOG

COMPANY Mahoney Drilling

SEC. 26 T. 31 R.

FARM Mills Feed, Land and Cattle

NO. D-1

LOC. SW SW

TOTAL DEPTH 4750'


COUNTY Barber County, Kansas

COMM. 6-27-75

COMP. 7-9-75

CONTRACTOR DaMac Drilling Company, Inc.

CASING 8 5/8" @ 331' w/100 sxs

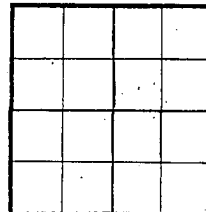

ELEVATION

PRODUCTION

FIGURES INDICATE BOTTOM OF FORMATIONS

0 - 420'	Topsoil, Red Bed, and Shale
420' - 1885'	Red Bed and Shale
1885' - 2210'	Shale
2210' - 4010'	Lime and Shale
4010' - 4135'	Lime
4135' - 4353'	Lime and Shale
4353' - 4665'	Lime
4665' - 4730'	Lime and Shale
4730' - 4750'	Lime

RECEIVED
STATE CORPORATION COMMISSION

JUL 16 1975
7-16-75
CONSERVATION DIVISION
Wichita, Kansas

State of Kansas }
County of Barton } ss

I, Marlene Mendenhall of DaMac Drilling Company, Inc.

upon oath state the above and foregoing is a true and correct copy of the log of the Mills Feed, Land and Cattle well.

DONALD SLOUP
STATE NOTARY PUBLIC
Barton County, Kansas
My Commission Expires
November 11, 1978

Marlene Mendenhall

Subscribed and sworn to before me this 15 day of July 19 75

My Commission Expires: 11-11-78

Donald Sloup
NOTARY PUBLIC