


STATE OF KANSAS
STATE CORPORATION COMMISSION

WELL PLUGGING RECORD

Give All Information Completely
Make Required Affidavit
Mail or Deliver Report to
Conservation Division
State Corporation Comm.
245 North Water
Wichita, KS 67202

Barber County, Sec. 8 Twp. 31 S Rge. 14 ~~EX~~W
Location as "NE/CNW $\frac{1}{4}$ SW $\frac{1}{4}$ " or footage from lines
260' NE NE SE

Lease Owner Wild Boys and the Silver Bullet
Lease Name Mills (Great Guns of the West) Well No. 12
Office Address 807 N. Waco - Suite 3A - Wichita, KS 67203
Character of Well (Completed as Oil, Gas or Dry Hole)

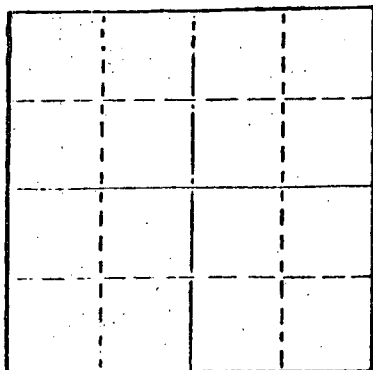

Locate well correctly on above
Section Plat

Dry Hole
Date Well completed 4-12 1982
Application for plugging filed 4-2 1982
Application for plugging approved 19
Plugging commenced 1-10-83 1983
Plugging completed (Completed 10:50) 1-19 1983
Reason for abandonment of well or producing formation
Depleted

If a producing well is abandoned, date of last production
19

Was permission obtained from the Conservation Division or
its agents before plugging was commenced? Yes

Name of Conservation Agent who supervised plugging of this well Tarbutton on top/P. Luthi on bott
Producing formation Depth to top Bottom Total Depth of Well 4,585

Show depth and thickness of all water, oil and gas formations.

OIL, GAS OR WATER RECORDS

CASING RECORD

FORMATION	CONTENT	FROM	TO	SIZE	PUT IN	PULLED OUT
				8 5/8"	896'	None
				5 1/2"	4,592'	2400'

Describe in detail the manner in which the well was plugged, indicating where the mud fluid
was placed and the method or methods used in introducing it into the hold. If cement or other
plugs were used, state the character of same and depth placed, from feet to
feet for each plug set.

Plugged back at 2,913.
Sand from 2,913 - 2,675.
5 sacks cement from 2,675 to 2,645
Sun Cementing Company pumped in 3 sacks hulls - 15 jell - 70 cement - 20 jell - 1 hull -
Dropped plug. 100 sack's cement. 50-50 POZ - 2% jell - 3% C. C.

Maximum Pressure - 950 lbs. - Shut in at 800 lbs.
Randy Zimmerman on location

(If additional description is necessary, use BACK of this sheet)

Name of Plugging Contractor Clarke Corporation

STATE OF Kansas COUNTY OF Barber, ss.
Elmer P. Magaster (employee of owner) or (owner or operator)
of the above-described well, being first duly sworn on oath, says: That I have knowledge of
the facts, statements, and matters herein contained and the log of the above-described well
as filed and that the same are true and correct. So help me God.

(Signature) Elmer P. Magaster
Medicine Lodge, Kansas
(Address)

SUBSCRIBED AND SWORN TO before me this 1st day of February, 19 83

My commission expires April 4, 1986.

Jessie J. [Signature]
STATE CORPORATION COMMISSION Notary Public.

FEB 7 1983
2-7-83
CONSERVATION DIVISION
Wichita Kansas