

15-007-10165-0000


STATE OF KANSAS
STATE CORPORATION COMMISSION

WELL PLUGGING RECORD

Give All Information Completely
Make Required Affidavit
Mail or Deliver Report to:
Conservation Division
State Corporation Commission
800 Bitting Building
Wichita, Kansas

Barber County, Sec. 8 Twp. 31S Rge. 14W (E) (W)
Location as "NE/CNW/SW" or footage from lines C of W/2 SE SW
Lease Owner Drillers Production Co., Inc.
Lease Name D. W. Skinner Well No. 1
Office Address 212 N. Market - Wichita, Kansas
Character of Well (completed as Oil, Gas or Dry Hole) Gas
Date well completed July 16 1945
Application for plugging filed December 1 1954
Application for plugging approved December 2 1954
Plugging commenced December 13 1954
Plugging completed December 17 1954
Reason for abandonment of well or producing formation Depleted

NORTH

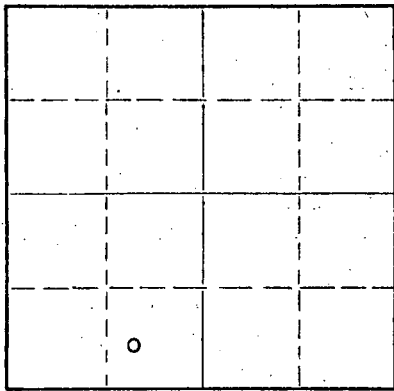

Locate well correctly on above
Section Plat

If a producing well is abandoned, date of last production October 11 1954
Was permission obtained from the Conservation Division or its agents before plugging was commenced? Yes

Name of Conservation Agent who supervised plugging of this well Merle Rives
Producing formation Toronto Depth to top 3600 Bottom 3604 Total Depth of Well 4405 Feet
Show depth and thickness of all water, oil and gas formations.

OIL, GAS OR WATER RECORDS

CASING RECORD

FORMATION	CONTENT	FROM	TO	SIZE	PUT IN	PULLED OUT
Douglas		3436		13" OD	183'	None
Lansing		3771		8-5/8"	672'	None
Viola		4327		5-1/2"	4404 1/2'	3006'
Lane Wells plug set at 3650' and casing perforated from 3604' to 3606'.						

Describe in detail the manner in which the well was plugged, indicating where the mud fluid was placed and the method or methods used in introducing it into the hole. If cement or other plugs were used, state the character of same and depth placed, from _____ feet to _____ feet for each plug set.

Filled hole with sand from 3650' to 3595' and ran 5 sacks of cement. Pumped in 20 sacks of Aquagel. Mudded hole to 300', set a 15' rock bridge to 285' and ran 20 sacks of cement at 285'. Mudded hole to 40', set a 10' rock bridge and ran 10 sacks of cement on top. Plugging completed.

(If additional description is necessary, use BACK of this sheet)

Name of Plugging Contractor West Supply Co., Inc.
Address Chase, Kansas

STATE OF Kansas, COUNTY OF Sedgwick, ss.
C. R. Bickford, Jr. (employee of owner) or ~~owner or operator~~ of the above-described well, being first duly sworn on oath, says: That I have knowledge of the facts, statements, and matters herein contained and the log of the above-described well as filed and that the same are true and correct. So help me God.

(Signature) C. R. Bickford, Jr.
Insurance Bldg, 212 N. Market St., Wichita, Kans.
(Address)

SUBSCRIBED AND SWORN to before me this 23 day of December, 19 54

My commission expires August 13, 1955 Bertha L. Wilson Notary Public.

PLUGGING
FILE SEC 8 T 31 R 14W
BOOK PAGE 81 LINE 9

12-24-54


WELL LOG BUREAU—KANSAS GEOLOGICAL SOCIETY
412 Union National Bk. Bldg., Wichita, Kansas

Company DRILLERS GAS CO.
Farm D. W. Skinner No. 1

SEC. 8 T. 31 R. 14 W
CW/2 SE SW

Total Depth. 4408'
Comm. 5-21-45 Comp. 6-17-45
Shot or Treated.
Contractor. R. C. Patton Co.
Issued. 8-4-45

County. Barber
KANSAS

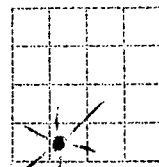

CASINGS:

13" 183' Cem.
8 5/8" 672' Cem.
5 1/2" 4406' Cem.

Elevation.....
Production. Pot. 7,563,000 G.

Figures indicate Bottom of Formations.

cellar	8
sand & gravel	65
sand	141
sand & red bed	183
red bed	360
red bed & shells	505
red bed	530
anhydrite	535
red bed	635
anhydrite	650
shale	725
red bed	730
red bed & shells	1000
shale & shells	1425
lime & shale	1550
shale & salt	1610
shale & lime	1830
lime	1947
shale & lime	2160
sand sharp	2170
lime sdy	2210
shale & lime	2260
shale & shells	2300
shale & lime	2390
shale & shells	2595
lime sft	2620
shale & lime	2682
lime	2715
shale & lime	2938
lime	2998
shale & lime	3168
shale & sft lime	3266
shale & lime	3749
lime	3801
shale & lime	3850
lime K.C.	3878
lime & chert	3936
lime	4237
lime & chert	4270
shale	4293
shale	4321
lime	4408

8-26-1950
Set bridge plug @ 4301
Perf 12/s 3856-62 wtr
Perf 12/s 3662-66 wtr

8-28-1950
Set bridge plug @ 3650
Perf 12/s 3600-04
2,514,000 cfg.

Total Depth.

Tops:
Douglas 3436
Lansing 3771
Viola 4327

RECEIVED
OIL COMMISSION
DEC 10 1954
12-10-54
REGISTRATION DIVISION
Wichita, Kansas

PLUGGING
FILE SEC. 8 T. 31 R. 14 W
BOOK PAGE 81 LINE 9