


WELL PLUGGING RECORD

Give All Information Completely  
Make Required Affidavit  
Mail or Deliver Report to:  
Conservation Division  
State Corporation Commission  
211 No. Broadway  
Wichita, Kansas

Barber County, Sec. 30 Twp. 33 Rge. 12 (E) (W)

Location as "NE/CNWxSWx" or footage from lines NW/SE/SW  
Lease Owner Rupp-Ferguson Oil Co.  
Lease Name Page McCullough Well No. Unit #1  
Office Address Box 163, Ellinwood, Kansas  
Character of Well (completed as Oil, Gas or Dry Hole) \_\_\_\_\_  
Date well completed \_\_\_\_\_ 19\_\_\_\_  
Application for plugging filed Yes 19\_\_\_\_  
Application for plugging approved Yes 19\_\_\_\_  
Plugging commenced \_\_\_\_\_ 3-3 19 58  
Plugging completed \_\_\_\_\_ 3-7 19 58  
Reason for abandonment of well or producing formation \_\_\_\_\_

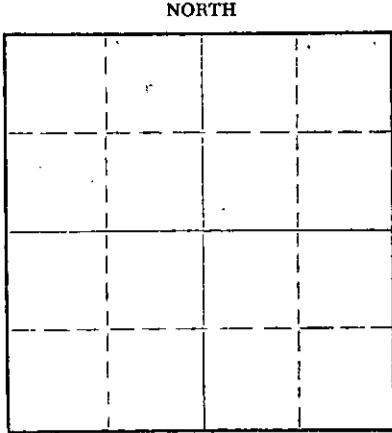

Locate well correctly on above Section Plat

If a producing well is abandoned, date of last production \_\_\_\_\_ 19\_\_\_\_  
Was permission obtained from the Conservation Division or its agents before plugging was commenced? Yes

Name of Conservation Agent who supervised plugging of this well Mr. W.L. LaCamp  
Producing formation \_\_\_\_\_ Depth to top \_\_\_\_\_ Bottom \_\_\_\_\_ Total Depth of Well 4624' Feet  
Show depth and thickness of all water, oil and gas formations.

OIL, GAS OR WATER RECORDS

CASING RECORD

FORMATION	CONTENT	FROM	TO	SIZE	PUT IN	PULLED OUT
				5 1/2"		3,838'

Describe in detail the manner in which the well was plugged, indicating where the mud fluid was placed and the method or methods used in introducing it into the hole. If cement or other plugs were used, state the character of same and depth placed, from \_\_\_\_\_ feet to \_\_\_\_\_ feet for each plug set.

Measured into T.D. 4624'.  
Plugging started 3-3-58. Finished 3-7-58.  
Plugged bottom of hole with 12 sacks cement. Shot 5 1/2" casing at 3,838'. Circulated 60 sacks gel mud. Pulled pipe out of hole. Mudded to 250'. Set rock bridge and dumped 35 sacks cement. Filled hole with mud to 35'. Set rock bridge and mixed 20 sacks cement for cap on well. Well completed.

RECEIVED  
STATE CORPORATION COMMISSION  
MAR 20 1958  
CONSERVATION DIVISION  
WICHITA, KANSAS

(If additional description is necessary, use BACK of this sheet)  
Name of Plugging Contractor J.O. Forbes d/b/a Forbes Casing Pulling Co.  
Address Box 221, Great Bend, Kansas

STATE OF Kansas, COUNTY OF Barton, ss.  
J.O. Forbes (employee of owner) or (owner or operator) of the above-described well, being first duly sworn on oath, says: That I have knowledge of the facts, statements, and matters herein contained and the log of the above-described well as filed and that the same are true and correct. So help me God.

(Signature) J.O. Forbes  
Box 221, Great Bend, Kans. (Address)

SUBSCRIBED AND SWORN TO before me this 12th day of March, 1958

My commission expires November 8, 1960  
Betty S. Edmer Notary Public.

PLUGGING  
FILE NO. 30 T. 33 R. 12 E  
BOOK PAGE 86 LINE 36

CONTRACTOR'S WELL LOG

Rupp-Ferguson No. 1 Page-McCullough Unit  
A NW SE SW, Sec. 30-33-13W,  
Darber County, Kansas

Elev. 1300 KB

Commenced: 7-17-36  
Completed: 8-4-36 R.T.D.  
Contractor: Rupp-Ferguson Oil Co.  
250' 1 3/8" surface casing w/800 sacks cement.  
4617' of 5 1/2" casing w/125 sacks cement.

Figures indicate Bottom of Formation

- 110 surface soil & clay
- 120 sand
- 290 red bed, shale & shells
- 040 red bed
- 060 shale & Anhy. streaks
- 1200 shale & shells
- 1390 salt
- 1435 lime & shale
- 1920 lime
- 2003 lime, shale streaks
- 2778 shale & lime
- 2993 shale
- 3628 lime & shale
- 3927 lime
- 4007 lime & shale
- 4030 lime
- 4140 lime & shale
- 4270 lime
- 4488 lime & shale
- 4516 Miss.
- 4551 lime & shale, Miss.
- 4606 Miss.
- 4758 lime & shale
- 4808 shale
- 4910 chert & lime
- 4920 Simpson  
T.D.

STATE OF KANSAS) SS:  
SEDGWICK COUNTY)

I, L. V. Knox, Agent for Rupp-Ferguson Oil Co., do hereby certify that the above and foregoing is a true and correct copy of the log of the No. 1 Page-McCullough Unit well.

PLUGGING  
FILE SEC 30 T 33 R 13W  
BOOK PAGE 86 LINE 36

RECEIVED  
S. W. ...  
MAR 20 1936  
DIVISION  
Oklahoma, Kansas

*L. V. Knox*  
L. V. Knox

Subscribed and sworn to before me this 10th day of August, 1936.

*Helen Horine*  
Notary Public

My Commission Expires June 4, 1939.