

WELL PLUGGING RECORD

All Information Completely  
 Required Affidavit  
 or Deliver Report to  
 Conservation Division  
 State Corporation Comm.  
 245 North Water  
 Wichita, KS 67202

Barber County. Sec. 31 Twp. 33S Rge. 12W XE/W  
 Location as "NE/CNW $\frac{1}{2}$ SW $\frac{1}{2}$ " or footage from lines  
 1650 FWL, 660 FSL


Lease Owner Petroleum Technical Services  
 Lease Name RH Donovan Well No. 31-1  
 Office Address 3000 N. Garfield, Suite 210, Midland, TX  
 Character of Well (Completed as Oil, Gas or Dry Hole)  
 Dry Hole

Date Well completed 8-26 1983  
 Application for plugging filed 8-26 1983  
 Application for plugging approved 8-26 1983  
 Plugging commenced 8-26 1983  
 Plugging completed 8-26 1983  
 Reason for abandonment of well or producing formation  
 Dry Hole

If a producing well is abandoned, date of last production  
 19

Was permission obtained from the Conservation Division or  
 its agents before plugging was commenced? Yes

Name of Conservation Agent who supervised plugging of this well Paul Luthi gave orders.  
 Producing formation Depth to top Bottom Total Depth of Well  
 depth and thickness of all water, oil and gas formations.

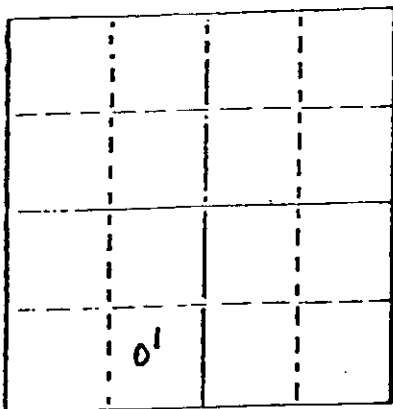

Locate well correctly on above  
 Section Plat

OIL, GAS OR WATER RECORDS

CASING RECORD

FORMATION	CONTENT	FROM	TO	SIZE	PUT IN	PULLED OUT
				8 5/8	504KB	

Describe in detail the manner in which the well was plugged, indicating where the mud fluid  
 placed and the method or methods used in introducing it into the hold. If cement or other  
 were used, state the character of same and depth placed, from feet to  
 feet for each plug set.

- 660' - 50 sacks
- 40' - 10 sacks
- 15 sacks in the rathole
- 10 sacks in the mousehole
- 60-40 pozmix, 2% gel, 3% cc

(If additional description is necessary, use BACK of this sheet)

Name of Plugging Contractor Eagle Drilling, Inc.

STATE OF Kansas COUNTY OF Sedgwick, ss.  
 Robert L. Eisel (employee of owner) or (owner or operator)

The above-described well, being first duly sworn on oath, says: That I have knowledge of  
 facts, statements, and matters herein contained and the log of the above-described well  
 filed and that the same are true and correct. So help me God.


(Signature)

*Robert L. Eisel*  
 P.O. Box 8609, Wichita, Kansas 67208  
 (Address)

SUBSCRIBED AND SWORN TO before me this 30th day of August, 1983

*Tiffany S. Little*  
 Tiffany S. Little Notary Public.

Commission expires 8-11-85

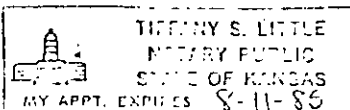

RECEIVED  
 STATE CORPORATION COMMISSION

SEP 22 1983

CONSERVATION DIVISION  
 Wichita, Kansas