


Give All Information Completely
Make Required Affidavit
Mail or Deliver Report to:
Conservation Division
State Corporation Commission
211 No. Broadway
Wichita, Kansas

WELL PLUGGING RECORD

Barber County. Sec. 17 Twp. 33S Rge. (E) 15 (W)
Location as "NE/CNWxSWx" or footage from lines. 100' E of NW NW NW
Lease Owner Sunray DX Oil Company
Lease Name Roy Platt Well No. 2
Office Address 321 W. Douglas, Wichita, Kansas 67202
Character of Well (completed as Oil, Gas or Dry Hole) Dry Hole
Date well completed March 19 19 64
Application for plugging filed March 20 19 64
Application for plugging approved March 23 19 64
Plugging commenced March 20 19 64
Plugging completed March 20 19 64
Reason for abandonment of well or producing formation None

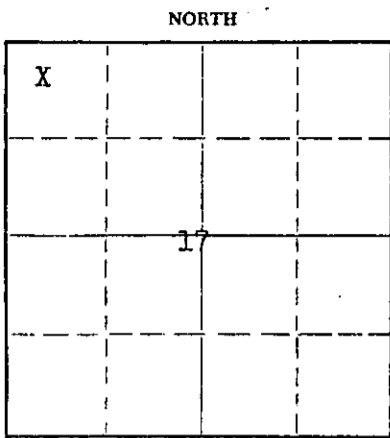

Locate well correctly on above
Section Plat

If a producing well is abandoned, date of last production None 19
Was permission obtained from the Conservation Division or its agents before plugging was commenced? Yes

Name of Conservation Agent who supervised plugging of this well Archie Elving
Producing formation None Depth to top Bottom Total Depth of Well 5060 Feet
Show depth and thickness of all water, oil and gas formations.

OIL, GAS OR WATER RECORDS

CASING RECORD

FORMATION	CONTENT	FROM	TO	SIZE	PUT IN	PULLED OUT
				8-5/8	217	None

Describe in detail the manner in which the well was plugged, indicating where the mud fluid was placed and the method or methods used in introducing it into the hole. If cement or other plugs were used, state the character of same and depth placed, from feet to 225 feet for each plug set.

Filled with mud to 225', added 1/2 sacks of hulls and a wood plug. Filled with mud to 40', set 1/2 sacks hulls and wood plug and 20 sacks of cement. Filled rathole with 5 sacks cement. Plugging completed.

Log attached.

RECEIVED
STATE CORPORATION COMMISSION

MAR 25 1964

CONSERVATION DIVISION
Wichita, Kansas

(If additional description is necessary, use BACK of this sheet)

Name of Plugging Contractor Stickle Drilling Company
Address 1100 Bitting Bldg., Wichita, Kansas

STATE OF KANSAS COUNTY OF SEDGWICK, ss:
R. D. Cypher (employee of owner ~~XXXXXXXXXXXXXXXXXX~~)

well, being first duly sworn on oath, says: That I have knowledge of the facts, statements, and matters herein contained and the log of the above-described well as filed and that the same are true and correct. So help me God.

(Signature) R. Dregellas
321 West Douglas, Wichita, Kansas 67202
(Address)

SUBSCRIBED AND SWORN TO before me this 24th day of March, 19 64

Commission expires July 13, 1967

W. M. Montgomery Notary Public.

Sunray DX Oil Company
Tulsa, Oklahoma

Tulsa, Oklahoma
March 23, 1964

634-48

Contractor: Stickle Drilling Company
Date Commenced: March 3, 1964
Date Completed: March 19, 1964

Roy Platt No. 2
NW NW NW Sec. 17, 33S-15W
Barber County, Kansas

DRILLER'S LOG

Depth Figures Indicate Base of Formation:

Red bed	240
Shells and shale	590
Shale and red bed	925
Shale	1642
Shale and shells	1885
Lime	2080
Shale and lime	2150
Lime	2191
Lime and shale	2605
Shale and lime	2710
Lime	2920
Shale and lime	3090
Lime and shale	3345
Shale and lime	3485
Lime and shale	3714
Shale and lime	3892
Lime and shale	3952
Lime	4532
Lime and shale	4617
Shale and lime	4716
Lime	4917
Cherty lime	5030
Sand and lime	5060 TD

RECEIVED
STATE CORPORATION COMMISSION

MAR 25 1964

CONSERVATION DIVISION
Wichita, Kansas

I, Fred E. Stickle, hereby certify the above to be a true and complete Driller's Log of Sunray DX Oil Company's Roy Platt No. 2, NW NW NW Section 17-33S-15W, Barber County, Kansas.


FRED E. STICKLE


Notary Public

My Commission Expires January 11, 1967