


Give All Information Completely.
Make Required Affidavit
Mail or Deliver Report to:
Conservation Division
State Corporation Commission
212 North Market, Insurance Bldg.
Wichita, Kansas

WELL PLUGGING RECORD

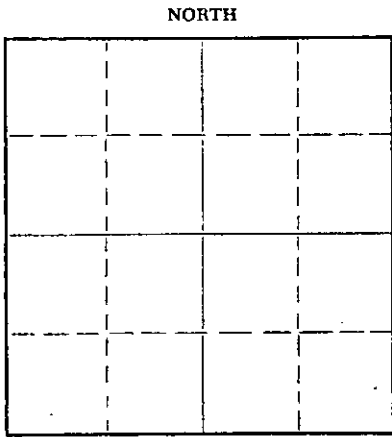

Locate well correctly on above Section Plat

Barber County, Sec. 17 Twp. 33 Rge. 15 (E) 15 (W)
Location as "NE/CNW&SW&W" or footage from lines SW SW SW
Lease Owner Aylward Drilling Company
Lease Name Platt Well No. 1
Office Address 813 First Nat'l Bank Bldg. - Wichita 2, Kansas
Character of Well (completed as Oil, Gas or Dry Hole) Dry Hole
Date well completed March 9 1960
Application for plugging filed March 9 1960
Application for plugging approved March 9 1960
Plugging commenced March 9 1960
Plugging completed March 9 1960
Reason for abandonment of well or producing formation _____

If a producing well is abandoned, date of last production _____ 19____
Was permission obtained from the Conservation Division or its agents before plugging was commenced? Yes

Name of Conservation Agent who supervised plugging of this well Fred Hample
Producing formation _____ Depth to top _____ Bottom _____ Total Depth of Well 5195 Feet
Show depth and thickness of all water, oil and gas formations.

OIL, GAS OR WATER RECORDS

CASING RECORD

FORMATION	CONTENT	FROM	TO	SIZE	PUT IN	PULLED OUT
				8 5/8"	1346	None

Describe in detail the manner in which the well was plugged, indicating where the mud fluid was placed and the method or methods used in introducing it into the hole. If cement or other plugs were used, state the character of same and depth placed, from _____ feet to _____ feet for each plug set.

Mud to 300 feet, set plug and 15 sacks cement.
Mud to 40 feet, set plug and 10 sacks cement.
Bridge rathole and plug with 2 sacks cement.

RECEIVED
STATE CORPORATION COMMISSION
APR 21 1960
CONSERVATION DIVISION
Wichita, Kansas

(If additional description is necessary, use BACK of this sheet)
Name of Plugging Contractor Aylward Drilling Company
Address 813 1st Nat'l Bank Bldg. - Wichita 2, Kansas

STATE OF KANSAS, COUNTY OF SEDGWICK, ss.
Charles D. Williams (employee of owner) ~~or (owner or operator)~~ of the above-described well, being first duly sworn on oath, says: That I have knowledge of the facts, statements, and matters herein contained and the log of the above-described well as filed and that the same are true and correct. So help me God.

(Signature) Charles D. Williams
813 1st Nat'l Bank Bldg., Wichita 2, Kansas
(Address)

SUBSCRIBED AND SWORN to before me this 14th day of March, 1960

My commission expires December 11, 1961

Duane Jessop
DUANE JESSOP Notary Public.

Casing Records:
8 5/8" - 1346'

Company: Aylward Drilling Company
Contractor: Aylward Drilling Company

Location: SW SW SW 17-33-15W
Barber County
Kansas

Date Commenced: February 12, 1960
Date Completed: March 9, 1960

Elevation: 1744 K.B.

	<u>From</u>	<u>To</u>	<u>Remarks</u>
Red Rock & Gyp	0	125	Set 8 5/8" surface pipe @ 1346 w/150 sax cement.
Red Bed	125	900	
Red Bed & Shale	900	1330	Schlumberger Tops:
Red Rock	1330	1475	
Shale & Shells	1475	1740	Topeka
Anhydrite	1740	1750	3171
Shale & Shells	1750	1935	Elgin
Shale & Lime	1935	1990	3790
Lime & Shale	1990	2150	Heebner
Lime	2150	2440	3952
Shale - Lime Streaks	2440	2550	Brown Lime
Lime w/Shale	2550	2665	4084
Lime & Shale	2665	2830	Stalnaker
Chalky Lime & Shale	2830	2940	4108
Shale & Lime	2940	3300	Lansing
Sandy Lime & Shale	3300	3415	4128
Lime & Shale	3415	3490	Mississippian
Sandy Lime & Shale	3490	3585	4744
Shale & Lime	3585	3781	Chattanooga
Sandy Lime & Shale	3781	3855	4916
Shale & Lime	3855	4005	Viola
Lime & Shale	4005	4140	4951
Lime	4140	4717	Simpson
Lime & Shale	4717	4740	5096
Lime	4740	4790	Simpson Sand
Lime & Shale	4790	4817	5127
Lime	4817	4825	R.T.D.
Lime & Shale	4825	4855	5195
Lime	4855	4973	DST 4059-4140 Open 1 hr. Good blow.
Lime & Shale	4973	5004	Rec. 778' fluid, 74' Sl.GCM, 704' Sl.GCM/W.
Dolomite & Chert	5004	5074	IBHP 1530#/20" - FBHP 1460#/30" ..
Lime	5074	5105	FP 150-485#.
Cherty Dolomite	5105	5110	DST 4722-4817 Open 1 hr. Fair blow.
Cherty Lime	5110	5114	Rec. 70' mud. IBHP 95#/20" - FBHP 95#/30" ..
Lime & Sand	5114	5139	FP 25#-55#.
Lime & Shale	5139	5172	DST 4976-5110 Open 1 hr. Good blow.
	5172	5199 T.D.	Rec. 80' mud, 120' wtry mud, 300' muddy wtr.
			IBHP 1783#/20" - FBHP 1606#/30" ..
			FP 95#-245#.
			DST 5130-54 Open 1 hr. Rec. 2040' SW
			IBHP 1890#/20" - FBHP 1848#/30" ..
			FP 325#-1260#.
			D & A

I hereby certify that this is a true and correct copy of the above log to the best of my knowledge.

Charles D. Williams

Subscribed and sworn to before me this 11th day of March, 1960.

Duane Jessup
DUANE JESSUP Notary Public

My commission expires December 11, 1961

RECEIVED
STATE CORPORATION COMMISSION
APR 21 1960
CONSERVATION DIVISION
Wichita, Kansas