


WELL PLUGGING RECORD

STATE OF KANSAS
 STATE-CORPORATION COMMISSION
 Give All Information Completely
 Make Required Affidavit
 Mail or Deliver Report to:
 Conservation Division
 State Corporation Commission
 211 No. Broadway
 Wichita, Kansas

Barber County, Sec. 23 Twp. 33S Rge. 15W (E) (W)

Location as "NE/CNWxSWx" or footage from lines c SE SE
 Lease Owner Gralapp & Everly
 Lease Name Gentry Ranch # Well No. #2
 Office Address 528 State Bank Bldg., Winfield, Kansas
 Character of Well (completed as Oil, Gas or Dry Hole) Dry
 Date well completed Feb. 2 19 61
 Application for plugging filed Feb. 2 19 61
 Application for plugging approved Feb. 2 19 61
 Plugging commenced Feb. 2 19 61
 Plugging completed Feb. 2 19 61
 Reason for abandonment of well or producing formation _____

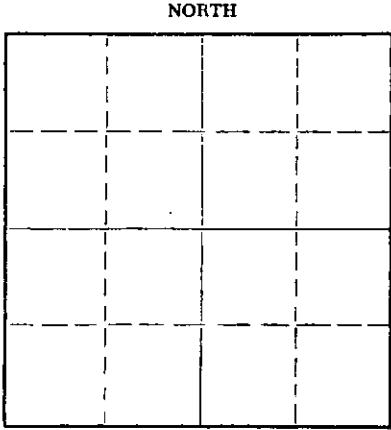

Locate well correctly on above
Section Plat

If a producing well is abandoned, date of last production _____ 19____
 Was permission obtained from the Conservation Division or its agents before plugging was commenced? yes

Name of Conservation Agent who supervised plugging of this well Gene Graham
 Producing formation _____ Depth to top _____ Bottom _____ Total Depth of Well 4943 Feet
 Show depth and thickness of all water, oil and gas formations.

OIL, GAS OR WATER RECORDS

CASING RECORD

FORMATION	CONTENT	FROM	TO	SIZE	PUT IN	PULLED OUT

Describe in detail the manner in which the well was plugged, indicating where the mud fluid was placed and the method or methods used in introducing it into the hole. If cement or other plugs were used, state the character of same and depth placed, from 4943 feet to 0 feet for each plug set.

Heavy mud from 4943 feet to 436 ft.; 30 sacks of cement; heavy mud to 80 ft.; 20 sacks cement to 0 ft.

RECEIVED
 STATE CORPORATION COMMISSION
 FEB 10 1961
 CONSERVATION DIVISION
 Wichita, Kansas

(If additional description is necessary, use BACK of this sheet)
 Name of Plugging Contractor Watson Drilling Company, Inc.
 Address 528 State Bank Bldg., Winfield, Kansas

STATE OF Kansas, COUNTY OF Cowley, ss.
Ben Gralapp, one of owners (employee of owner) or (owner or operator) of the above-described well, being first duly sworn on oath, says: That I have knowledge of the facts, statements, and matters herein contained and the log of the above-described well as filed and that the same are true and correct. So help me God.

(Signature) Ben Gralapp
Winfield, Kansas
 (Address)

SUBSCRIBED AND SWORN TO before me this 7th day of February, 19 61

My commission expires April 9, 1961

Grace Hill
 Notary Public.



WELL LOG

Company: Cralapp & Everly
Winfield, Kansas

GENTRY RANCH #2
c SE SE 23-333-15N
Barber County, Kansas

Contractor: Watson Drilling Co., Inc.
Winfield, Kansas

Casing Record:
419 ft. 8 5/8" surface set with
300 sacks cement

Comm: 1/10/61
Comp: 2/2/61

DRY & PLUGGED

shale	0	100
shale & shells	100	390
lime	390	412
red bed	412	850
shale & red rock	850	956
shale & shells	956	1125
shale	1125	1790
lime	1790	2233
shale	2233	2249
shale & lime	2249	2305
shale & sand	2305	2356
lime & shale	2356	2898
lime	2898	2926
lime & shale	2926	3083
shale & lime	3083	3160
shale	3160	3179
lime	3179	3206
shale	3206	3264
lime	3264	3355
lime & shale	3355	3440
lime	3440	3477
lime & shale	3477	3543
shale & lime	3543	3853
lime & shale	3853	3965
shale & lime	3965	4015
lime & shale	4015	4020
shale (Douglas)	4020	4070
shale & lime	4070	4164
lime	4164	4195
shale	4195	4230
lime	4230	4584
shale & sand strks.	4584	4621
lime	4621	4812
shale & sand (Cleveland)	4812	4850
lime	4850	4855
lime & shale	4855	4863
Mississippi lime	4863	4943

STATE OF KANSAS
STATE COMMISSION
FEB 1961
CONSERVATION DIVISION
Wichita, Kansas

T.D. 4943

STATE OF KANSAS,)
) SS:
COUNTY OF CORLEY,)

I hereby certify that the above is a true and correct drilling log of the Gentry Ranch #2 well in Barber County, Kansas, as taken by me from the Daily Drilling Report of the Watson Drilling Company this 6th day of February, 1961.

Notary Public

My commission expires:

April 9, 1961