

WELL PLUGGING RECORD

STATE OF KANSAS STATE CORPORATION COMMISSION

Give All Information Completely Make Required Affidavit Mail or Deliver Report to: Conservation Division State Corporation Commission 800 Bitting Building Wichita, Kansas


OR

FORMATION PLUGGING RECORD

Strike out upper line when reporting plugging of formations.

Barber County. Sec. 18 Twp. 31 Rge. 14 (E) Location as "NE 1/4 NW 1/4 SW 1/4" or footage from lines. SE 1/4 - NW 1/4 - NE 1/4 Lease Owner. Champlin Refining Company Lease Name. Oldfather Well No. 1 Office Address. P. O. Drawer #552, Enid, Oklahoma. Character of Well (completed as Oil, Gas or Dry Hole). Oil Date well completed. July 24, 1945 Application for plugging filed. April 16, 1944 Application for plugging approved. April 21, 1947 Plugging commenced. March 23, 1948 Plugging completed. March 30, 1948 Reason for abandonment of well or producing formation. Production exhausted

NORTH

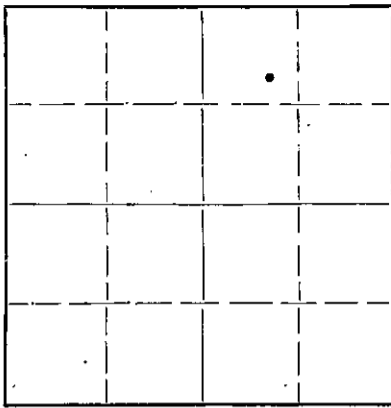

Locate well correctly on above Section Plat

If a producing well is abandoned, date of last production. January 24, 1946. Was permission obtained from the Conservation Division or its agents before plugging was commenced? Yes

Name of Conservation Agent who supervised plugging of this well. Mr. C. D. Stough, Great Bend, Kansas. Producing formation. Viola Depth to top. 4440' Bottom. 4453' Total Depth of Well. 4453' Feet Show depth and thickness of all water, oil and gas formations.

OIL, GAS OR WATER RECORDS

CASING RECORD

Table with 7 columns: Formation, Content, From, To, Size, Put In, Pulled Out. Contains data for 10 1/2" OD and 5 1/2" OD casings.

Describe in detail the manner in which the well was plugged, indicating where the mud fluid was placed and the method or methods used in introducing it into the hole. If cement or other plugs were used, state the character of same and depth placed, from... feet to ... feet for each plug set.

Filled hole with heavy mud from 4453' to 4374' and set Lane Wells plug from 4374' to 4370' then set cement plug from 4370' to 4360' using 5 sacks cement, filled hole with heavy mud from 4360' to 716' and set cement plug from 716' to 686' using 20 sacks cement then filled hole with heavy mud from 686' to 200' and set cement plug from 200' to 176' using 15 sacks of cement, filled hole with heavy mud from 176' to 15' and set cement plug from 15' to bottom of cellar using 10 sacks of cement.

(If additional description is necessary, use BACK of this sheet)

Correspondence regarding this well should be addressed to. Champlin Refining Company Address. P. O. Drawer #552, Enid, Oklahoma.

STATE OF Kansas COUNTY OF Barton ss. S. P. Hall (employee of owner)

being first duly sworn on oath, says: That I have knowledge of the facts, statements, and matters herein contained and the log of the above-described well as filed and that the same are true and correct. So help me God.

(Signature) S. P. Hall 4-27-48


P. O. Box 167, Ellinwood, Kansas.

SUBSCRIBED AND SWORN to before me this 16th day of April, 1948

(Signature) M. Kenneth Stearns

Notary Public.

My commission expires October 24, 1951

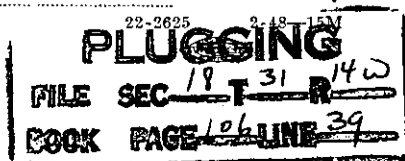

15-007-1093-0000

N

WELL RECORD

COUNTY Barber SEC. 18 TWP. 31S RGE. 14W
 COMPANY OPERATING Champion Refining Company
 OFFICE ADDRESS Enid, Oklahoma
 FARM NAME Oldfather WELL NO. 1
 WELL LOCATED 1650 feet from East line and 990 feet
from North line
 CHARACTER OF WELL Oil

CASING RECORD

SIZE	WT.	THDS.	MAKE	FT.	IN.	AMOUNT PULLED	CEMENT
10 3/4"			Spiral	716'		none	400 bag
5 1/2"	14#	8 rd.	Seamless	4463'		none	200 bag

FORMATION RECORD

FORMATION	TOP	BOTTOM	FORMATION	TOP	BOTTOM
Surface Clay	0	40	Lime, gasodor, K.C.	3883	3905
Sand	40	80	Lime	3905	3930
Shale & Shells	80	1430	Cherty Lime	3930	3975
Shale & Lime	1430	1690	Lime & Chert	3975	3984
SANDY Lime	1690	1780	Shale	3984	4004
Shale & Lime	1780	1920	Lime & Chert	4004	4008
Lime & Chert	1920	1960	Shale	4008	4015
Lime	1960	2040	Shale & Lime	4015	4048
Shale & Lime	2040	2055	Lime	4048	4105
Lime	2055	2195	Hard Lime	4105	4120
Cherty Lime	2195	2210	Lime	4120	4245
Lime	2210	2280	Lime & Shale	4245	4275
Lime & Shale	2280	2345	Lime	4275	4295
Lime, Hard	2345	2370	Shale & Lime	4295	4330
Lime	2370	2380	Lime & Shale	4330	4370
Shale	2380	2390	Shale & Lime	4370	4400
Lime	2390	2435	Lime	4400	4453
Shale & Lime	2435	2510	T. D.		4463
Lime	2510	2610			
Lime & Shale	2610	2670			
Lime	2670	2720			
Shale & Lime	2720	2780			
Lime	2780	2820			
Lime & Shale	2820	2880	Top, Florence		2190
Shale & Lime	2880	2935	Top, Lansing		3792
Lime & Shale	2935	3025	Top, Kinderhook		4343
Lime	3025	3272	Top, Viola		4407
Sandy Lime	3272	3312			
Lime	3312	3410			
Lime & Shale	3410	3480			
Lime	3480	3645			
Shale & Lime, broken	3645	3720			
Lime	3720	3883			

APR 21 1947
4-21-47

FORMATION TOPS

Top, Florence	2190
Top, Lansing	3792
Top, Kinderhook	4343
Top, Viola	4407

H. C. Wentworth
Superintendent.

Subscribed and sworn to before me this
16 day of May 1947

Daisy Norris
Notary Public

My Commission Expires: November 10, 1948

PLUGGING
 BOOK PAGE 106 LINE 39