


STATE OF KANSAS  
STATE CORPORATION COMMISSION

Give All Information Completely  
Make Required Affidavit  
Mail or Deliver Report to:  
Conservation Division  
State Corporation Commission  
P. O. Box 17027  
Wichita, Kansas 67217  
NORTH

WELL PLUGGING RECORD

Barber County, Sec 18 Twp 31 Rge 14 (E) (W)  
Location as "NE/CNW/SE" or footings from lines C NW SE  
Lease Owner Raymond Oil Co., Inc.  
Lease Name Shaft A#1 Well No.  
Office Address Wichita, Kansas 67202  
Character of Well (completed as Oil, Gas or Dry Hole)  
Date well completed 19  
Application for plugging filed 19  
Application for plugging approved 19  
Plugging commenced kxx 11/3/73 19  
Plugging completed 11/10/73 19  
Reason for abandonment of well or producing formation depleted.  
If a producing well is abandoned, date of last production 19  
Was permission obtained from the Conservation Division or its agents before plugging was commenced? yes

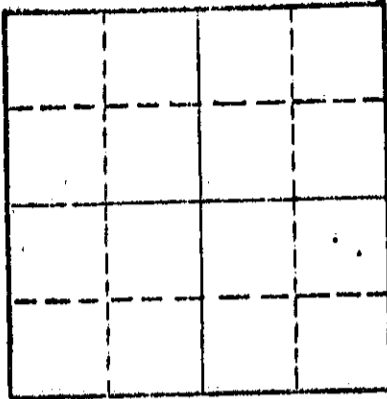

Locate well coverage on above Section Plat

Name of Conservation Agent who supervised plugging of this well Biberstein  
Producing formation Depth to top Bottom Total Depth of Well 4605 Feet  
Show depth and thickness of all water, oil and gas formations.

OIL, GAS OR WATER RECORDS

CASING RECORD

FORMATION	CONTENT	FROM	TO	SIZE	PUT IN	PULLED OUT
				8-5/8	1720	none
				13-3/8	218	none
				5 1/2"	4600	2768'

Describe in detail the manner in which the well was plugged, indicating where the mud fluid was placed and the method or methods used in introducing it into the hole. If cement or other plugs were used, state the character of same and depth placed, from feet to feet for each plug set.

Checked bottom, ran sand to 4400' and dumped 5 sacks cement.  
Shot pipe at 2979', 2913', 2820', pulled 86 joints. Bailed hole to 400' and set 10' rock bridge. Dumped 7 yards ready mix.

PLUGGING COMPLETE

RECEIVED  
STATE CORPORATION COMMISSION

NOV 19 1973  
11-19-73  
CONSERVATION DIVISION  
Wichita, Kansas

(If additional description is necessary, use BACK of this sheet)  
Name of Plugging Contractor KNIGHT CASING PULLING CO., INC.  
Address CHASE, KANSAS

STATE OF KANSAS, COUNTY OF RICE  
NOEL J. KNIGHT (employee of owner) or (owner or operator) of the above-described well, being first duly sworn on oath, says: That I have knowledge of the facts, statements, and matters herein contained and the log of the above-described well as filed and that the same are true and correct. So help me God.

(Signature) [Signature]  
CHASE, KANSAS  
(Address)

Subscribed and sworn to before me this 12th day of November, 1973

[Signature]  
Notary Public.

My commission expires  
MARGARET MELCHER  
NOTARY PUBLIC  
Rice County, Kansas  
My Commission Expires  
Feb. 15, 1975



KANSAS GEOLOGICAL SOCIETY  
508 East Murdock  
Wichita, Kansas

15-007-20582-0000

ORIGINAL

APR 19 1968

DRILLER'S LOG

NO CARD

COMPANY	Tilco, et al
CONTRACTOR	LEBEN DRILLING, INC.
FARM	SHAFT A-#1
LOCATION	C NW SE SECTION 18 31S-14W BARBER COUNTY, KANSAS
COMMENCED	11-26-68
COMPLETED	12-10-68

10' E 9

Red

0 500  
500 1500  
1500 1602  
1602 1612  
1612 2040  
2040 2160  
2160 3050  
3050 3522  
3522 3995  
3995 4525  
4525 4605  
4605

Red Bed  
Shale  
Red Bed  
Anhydrite  
Shale, Lime  
Lime, Shale  
Lime  
Shale, Lime  
Lime, Shale  
Lime  
Chert, Lime  
RTD

RECEIVED  
STATE CORPORATION COMMISSION  
OCT 24 1973  
10-24-73  
CONSERVATION DIVISION  
Wichita, Kansas

NO CARD

8 5/8" 24# new surface casing set @ 1720' cemented with 150 sacks Common cement, 2% cc

RECORDED  
DEC 21 1968

Published By  
KANSAS GEOLOGICAL SOCIETY  
508 East Murdock  
WICHITA, KANSAS 67214

ORIGINAL

DRILLER'S LOG

COMPANY	Tilco, et al
CONTRACTOR	LEBEN DRILLING, INC.
FARM	SHAFT A-1
LOCATION	C NW SE SECTION 18-31S-14W BARBER COUNTY, KANSAS
COMMENCED	11-21-68
COMPLETED	11-25-68

Red

0 1200  
1200 1780  
1780 1980  
1980 1988  
1988

Redbed  
Shale  
Lime, Shale  
Shale  
RTD - Skid Rig

8 5/8" 24# new surface casing set @ 250' cemented with 200 sacks Common cement, 3% cc

I, Leslie Kite, do hereby certify that the above and foregoing is a true and correct copy of the log of the Shaft A-#1 Well, located C NW SE of Section 18, Township 31 South, Rangle 14 West, Barber County, Kansas, as reflected by the records of Leben Drilling, Inc.

Leslie Kite