


15-007-10187-0000

WELL PLUGGING RECORD

Give All Information Completely  
Make Required Affidavit  
Mail or Deliver Report to:  
Conservation Division  
State Corporation Commission  
800 Bitting Building  
Wichita, Kansas

NORTH

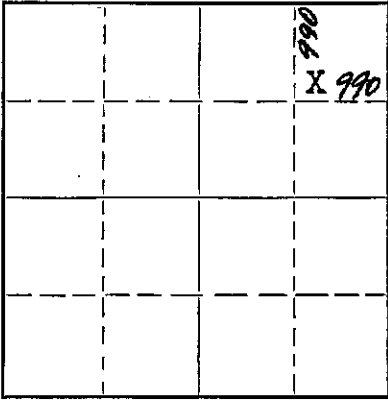

Locate well correctly on above  
Section Plat

Barber County, Sec. 17 Twp. 31S. Rge. 14 (W)  
Location as "NE/CNW $\frac{1}{4}$ SW $\frac{1}{4}$ " or footage from lines Cen SW NE NE  
Lease Owner J.M. HUBER CORP. & BISHOP OIL CO.  
Lease Name Skinner "A" Well No. 1  
Office Address Box 978 Liberal, Kansas  
Character of Well (completed as Oil, Gas or Dry Hole) Gas  
Date well completed 3-11-46 19  
Application for plugging filed 5-18-53 19  
Application for plugging approved 5-19-53 19  
Plugging commenced 4-18-53 19  
Plugging completed 4-22-53 19  
Reason for abandonment of well or producing formation  
Formation Dry  
If a producing well is abandoned, date of last production 19  
Was permission obtained from the Conservation Division or its agents before plugging was commenced? Yes

Name of Conservation Agent who supervised plugging of this well Mr. M.A. Rives  
Producing formation Viola Depth to top 4356' Bottom 4382' Total Depth of Well 4382 Feet  
Show depth and thickness of all water, oil and gas formations.

OIL, GAS OR WATER RECORDS

CASING RECORD

Formation	Content	From	To	Size	Put In	Pulled Out
Viola	Gas	4356'	4382'	16"	133'	None
				10 3/4"	778'	None
				5 1/2"	4356'	3015'

Describe in detail the manner in which the well was plugged, indicating where the mud fluid was placed and the method or methods used in introducing it into the hole. If cement or other plugs were used, state the character of same and depth placed, from \_\_\_\_\_ feet to \_\_\_\_\_ feet for each plug set.

Filled hole with rock from total depth to 3600'. Dumped 5 sacks of cement at 3600'. Shot and recovered 3015' of 5 1/2" casing. Filled hole with mud laden fluid from 3600' to 300'. Set a fresh water plug at 300' with 20 sacks of cement. Filled with mud laden fluid to 35'. Filled with 10 sacks of cement from 35' to the surface.

(If additional description is necessary, use BACK of this sheet)

Name of Plugging Contractor Carroll Bros. Casing Pulling Co.  
Address Ellinwood, Kansas

STATE OF Kansas, COUNTY OF Pratt, ss.  
R.E. McDaniel (employee of owner) or (owner or operator) of the above-described well, being first duly sworn on oath, says: That I have knowledge of the facts, statements, and matters herein contained and the log of the above-described well as filed and that the same are true and correct. So help me God.

(Signature) R.E. McDaniel

Box 978 Liberal, Kansas (Address)

SUBSCRIBED AND SWORN to before me this 26th day of May 19 53

My commission expires September 10, 1955

RECEIVED  
STATE CORPORATION COMMISSION Notary Public.

23-8390-s 6-51-20M

PLUGGING  
FILE SEC-17 T-31 R-14 W  
BOOK PAGE 102 LINE 17

MAY 28 1953  
5-28-53  
CONSERVATION DIVISION  
Wichita, Kansas

Farm: Skinner "A" No. 1  
 Company: J.M. Huber Corporation and Bishop Oil Company.  
 Contractor: J.M. Huber Corporation.  
 Commenced: 2- 8-46  
 Completed: 3-11-46

15-087-10187-0000

Location: SW NE NE  
 Sec. 17-31S-14W.  
 Barber county,  
 Kansas.

Production: 32,000 MCF  
 Elevation 1639 MDF  
 1636 Gr.

Drilled with Rotary and Cable

CASING USED:	16"	135'	200 sx.
	10"	788'	350 sx
	5 1/2"	4356'	250 sx

red beds and shells 675  
 shale and shells 1240  
 salt and shale 1470  
 lime and shale 1940  
 lime 1955  
 lime and shale 2015  
 shale 2080  
 broken lime and shale 2125  
 broken lime 2185  
 cherty lime 2200  
 shale and lime 2300  
 sand 2315  
 shale and lime 2420  
 sdy lime and shale 2550  
 shale and lime 2745  
 sdy lime and shale 2845  
 lime and shale 2905  
 lime and shale streaks 2990  
 lime and shale 3170  
 lime 3175  
 shale 3195  
 sdy lime and shale 3300  
 lime and shale 3395  
 broken lime 3565  
 lime and shale 3595  
 lime and shale streaks 3655  
 broken sand and lime 3685  
 lime and shale 3899  
 lime 3960  
 lime and shale 4079  
 lime 4173  
 lime and shale 4367  
 lime 4383  
 Total Depth.

TOPS:

Lansing 3771  
 Base Penn. 4281  
 Maquoketa 4353

4359-78. porous with no staining to very bare trace of staining.

Loaded hole and drilled plug to 4383, total depth. Ran 2" tubing. Unloaded hole with swab and blew gas for several hours; shut in one hour; after 20 min. blow down, gauged 6,150 MCF. Pumped 100 gal acid on bottom, let set one hour and blew off acid, estimated slight increase in gas volume. Treated with 5000 gal acid. Maximum pressure on casing 1850#, maximum pressure on tubing 400#. Time of treatment 39 Min. After flowing well for 2 hours, gas gauged 25,000 MCF. Gas was still very wet. After shut well in over night, opened and blew well for one hour, gas gauged 32,000 MCF.

**PLUGGING**  
 FILE SEC 17 T 31 R 14W  
 BOOK PAGE 102 LINE 14

STATE OF KANSAS )  
 ) SS  
 COUNTY OF SEDGWICK )

I hereby certify that the above is a true and correct copy of the log of the Skinner "A" No. 1 located in the Southwest Quarter of the Northeast Quarter of the Northeast Quarter (SW NE NE) of Section 17, Township 31 South, Range 14 West, Barber county, Kansas.

*Edward A. Huffman*  
 Edward A. Huffman,  
 District Manager.  
 J.M. Huber Corporation.

Subscribed and sworn to before me this 21 day of March, 1946.

*E. P. ...*  
 Notary Public  
 STATE CORPORATION COMMISSION

My Commission expires February 2, 1948

MAY 28 1953  
 5-28-53  
 CONSERVATION DIVISION  
 Wichita, Kansas

Farm: Skinner "A" No. 2  
 Company: J.M. Huber Corporation and  
 Bishop Oil Company.  
 Contractor: J.M. Huber Corporation.  
 Commenced: 2- 3-46  
 Completed: 2- 6-46

Location: SE NW NE  
 Sec. 17-31S-14W.  
 Barber county,  
 Kansas.

'Skidded Rig'

Elevation 1642

16" 70' 35 ex.

1st hole.

clay sand and shells	38
sand	54
red beds and shells	630 Total Depth.

Skidded rig.