


15-007-10191-0000

WELL PLUGGING RECORD

Give All Information Completely
Make Required Affidavit
Mail or Deliver Report to:
Conservation Division
State Corporation Commission
800 Bittling Building
Wichita, Kansas

NORTH

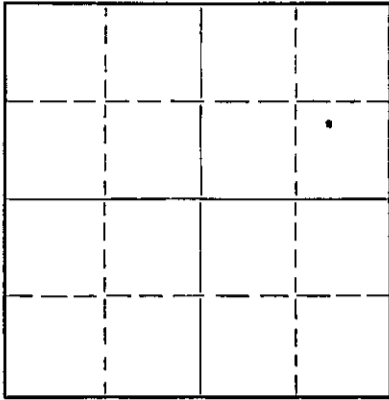

Locate well correctly on above
Section Plat

Barber County. Sec. 17 Twp. 31S. Rge. 11 (X) (W)
Location as "NE/CNW $\frac{1}{4}$ /SW $\frac{1}{4}$ " or footage from lines SW NW NE
Lease Owner J. M. Huber and Bishop Oil Company
Lease Name Skinner "A" Well No. 5
Office Address Liberal, Kansas
Character of Well (completed as Oil, Gas or Dry Hole) Oil
Date well completed 10-20-48 19
Application for plugging filed 5-8-53 19
Application for plugging approved 5-9-53 19
Plugging commenced 5-9-53 19
Plugging completed 5-15-53 19
Reason for abandonment of well or producing formation
Not profitable to produce
If a producing well is abandoned, date of last production 19
Was permission obtained from the Conservation Division or its agents before plugging was commenced? Yes

Name of Conservation Agent who supervised plugging of this well M. A. Rives, Pratt, Kansas
Producing formation Viola Depth to top 4369 Bottom 4390 Total Depth of Well 4390 Feet
Show depth and thickness of all water, oil and gas formations.

OIL, GAS OR WATER RECORDS

CASING RECORD

Formation	Content	From	To	Size	Put In	Pulled Out
Viola	Oil	4369	4390	16"	160'	None
				10 3/4"	805'	None
				5 1/2"	4369	3717'

Describe in detail the manner in which the well was plugged, indicating where the mud fluid was placed and the method or methods used in introducing it into the hole. If cement or other plugs were used, state the character of same and depth placed, from _____ feet to _____ feet for each plug set.

Filled hole w/rock from 4390 to 4340' and dumped 5 sacks of cement; loaded hole with water.
Pulled casing.
Set fresh water plug at 300' and dumped 20 sacks of cement. Filled hole up to 25' w/ mud laden fluid, set rock bridge and dumped 10 sacks of cement.

RECEIVED
STATE CORPORATION COMMISSION
JUL 18 1953
7-18-53
CONSERVATION DIVISION
Wichita, Kansas

(If additional description is necessary, use BACK of this sheet)

Name of Plugging Contractor Carroll Eros. Casing Pulling Co.
Address Ellinwood, Kansas

STATE OF KANSAS, COUNTY OF PRATT, ss.
R. E. McDaniel (employee of owner) or ~~owner~~ of the above-described well, being first duly sworn on oath, says: That I have knowledge of the facts, statements, and matters herein contained and the log of the above-described well as filed and that the same are true and correct. So help me God.

(Signature) R. E. McDaniel
Box 978 Liberal Kansas
(Address)

SUBSCRIBED AND SWORN to before me this 17th day of July, 1953

My commission expires Sept. 10, 1953 Notary Public.

PLUGGING
SEC 17 T 31 R 14W
PAGE 92 LINE 4


WELL LOG BUREAU — KANSAS GEOLOGICAL SOCIETY
412 Union National Bk. Bldg., Wichita, Kansas

Company - BISHOP OIL CO & HUBER CORP.
Farm - Skinner "A" No. 5

SEC. 17 T. 31 R. 14W
SW NE

Total Depth. 4390
Comm. 9-16-48 Comp. 11-4-48
Shot or Treated.
Contractor. Bishop Oil Co.
Issued. 6-25-49

County. Barber
KANSAS

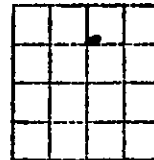

CASING:
16" 160 150 sx. com. 5 1/2" 4369 133 sx. com.
10 3/4" 805 2 1/2" 4385

Elevation. _____

Production. I P 533

Figures Indicate Bottom of Formations.

sand	137
red rock & shale	650
anhyd.	670
anhyd. & red rock	823
red bed	837
gypsum & shale	1160
anhyd. & salt	1550
shale & limo	1986
limo	2140
limo & shale	2216
limo	2446
shale & limo	2651
shale	2720
limo & shale	2877
limo	2944
shale & limo	3350
limo	3361
limo & shale	3620
sand	3658
limo sandy & shale	3758
shale & limo	3806
limo	3904
limo & shale	4013
limo	4157
limo & shale	4210
limo & chert	4238
limo RTD	4370
limo?	4390

Tops:

Hoobner	3595
Dansing	3781
Mississippi	4275
Mauckota	4348

10/26/48- drilled plug, HFO immediately
& flowed over derrick. Shut in till
finish test on #4.
10/27/48-sub & flow, 196 BO/12 hrs inc.
load (50 BO) made 12/BO hr.
10/28/48-acidized 1000 gal.
10/29/48-sub & agitated thru tubing.
15 BOFH, could get acid wtr back.
11/3/48-recovered acid wtr & wtr. cut
oil with casing sub. sub 16.20 BO/hr
for 5 hrs & est 1/2 MCF. Flowed over
rig when bailer was run.
11/15/48-raised tubing to 385 off
bottom. Started to flow. No test.

PLUGGING
FILE SEC 17-31 R 14W
BOOK PAGE 92 LINE 4

RELEASED
STATE CORPORATION COMMISSION
7-23-53
JUL 25 1953
CONSERVATION DIVISION
Wichita, Kansas