


STATE OF KANSAS
STATE CORPORATION COMMISSION

WELL PLUGGING RECORD

Give All Information Completely
Make Required Affidavit
Mail or Deliver Report to:
Conservation Division
State Corporation Commission
800 Bitting Building
Wichita, Kansas

Barber County, Sec. 17 Twp. 31S Rge. 14 (X) (W)
Location as "NE/CNW/SW" or footage from lines Gen NW NW SE
Lease Owner J.M. Huber Corp. & Bishop Oil Co.
Lease Name Skinner "C" Well No. 2
Office Address Box 978 Liberal, Kansas
Character of Well (completed as Oil, Gas or Dry Hole) Oil
Date well completed 3-12-49 19
Application for plugging filed 4-10-53 19
Application for plugging approved 4-13-53 19
Plugging commenced 5-4-53 19
Plugging completed 5-8-53 19
Reason for abandonment of well or producing formation Formation Dry
If a producing well is abandoned, date of last production _____ 19
Was permission obtained from the Conservation Division or its agents before plugging was commenced? Yes

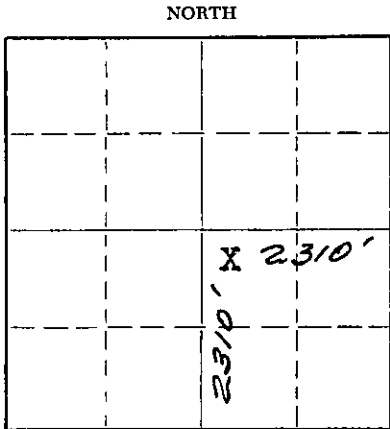

Locate well correctly on above Section Plat

Name of Conservation Agent who supervised plugging of this well Mr. M.A. Rives
Producing formation Viola Depth to top 4362' Bottom 4371' Total Depth of Well 4397' Feet
Show depth and thickness of all water, oil and gas formations.

OIL, GAS OR WATER RECORDS

CASING RECORD

FORMATION	CONTENT	FROM	TO	SIZE	PUT IN	PULLED OUT
Viola	Oil	4362'	4371'	16"	140'	None
				10 3/4"	807'	None
				5 1/2"	4362'	3417'

Describe in detail the manner in which the well was plugged, indicating where the mud fluid was placed and the method or methods used in introducing it into the hole. If cement or other plugs were used, state the character of same and depth placed, from _____ feet to _____ feet for each plug set.

Filled hole with rock from total depth to 4360'. Dumped 5 sacks of cement at 4360'. Shot and recovered 3417' of 5 1/2" casing. Filled with mud laden fluid from 4360' to 300'. Set a Fresh water plug With 20 sacks of cement at 300'. Filled with mud laden fluid to 25'. Set bridge at 25' and cemented to surface with 10 sacks of cement.

(If additional description is necessary, use BACK of this sheet)

Name of Plugging Contractor Carroll Bros. Casing Pulling Co.
Address Ellinwood, Kansas

STATE OF Kansas, COUNTY OF Pratt, ss.
R.E. McDaniel (employee of owner) or ~~(owner or operator)~~ of the above-described well, being first duly sworn on oath, says: That I have knowledge of the facts, statements, and matters herein contained and the log of the above-described well as filed and that the same are true and correct. So help me God.

(Signature) R.E. McDaniel

Box 978 Liberal, Kansas
(Address)

SUBSCRIBED AND SWORN TO before me this 26th day of May, 19 53

My commission expires September 10, 1955

J. L. Kyler
Notary Public.

24-2675-S 2-52-20M

PLUGGING
FILE SEC 17 T 31 R 14W
BOOK PAGE 92 LINE 6

5-28-53

DRILLER'S LOG

15-007-1085-0000

COMPANY: BISHOP & HUBER
CONTRACTOR: J. N. HUBER CORPORATION
WELL NAME: SHINNER #00 NO. 2

LOCATION: NW 1/4 SW, 17-31-140
Harbor County, Kansas

COMPLETION: 2-1-49
COST: \$1000.00

PERMITS: 1654
PRODUCTION: 70 barrels oil per day plus 55
7 water.

CASING USED: 16" at 140' with 300 casing.
5 1/2" at 4362' with 250 casing.

Sandy Red Bed, Shells & Sand	10
Sand & Shales	60
Shale & Shells	140
Red Bed & Shell	335
Red Bed & Shells	507
Shells & Shales	1170
Salt, Shale & Shells	1405
Shale & Shells	1695
Lime & Shale	1795
Shale & Lime	1845
Lime & Shale Brecks	2010
Lime & Shale	2125
Shale & Lime Shells	2520
Shale & Lime	2620
Lime & Shale	2700
Lime, Shells & Shale	2805
Shale & Lime	2900
Lime & Shale	3105
Lime & Shale Brecks	3175
Lime & Shale Brecks	3245
Sand & Lime	3335
Shale & Lime	3390
Broken Lime & Shale Brecks	3475
Lime & Shale	3660
Shale & Shells	3680
Lime Broken	3740
Shale & Lime	3827
Lime	3846
Lime with Shale Brecks	3913
Lime & Shale	3940
Lime & Shale Brecks	3998
Lime	4074
Lime & Chert	4092
Cherty Lime	4113
Lime	4165
Lime & Shale Brecks	4193
Lime & Shale	4262
Lime-Cherty	4294
Shale & Lime	4325
Shale	4366
Rotary Total Depth	4366

SAMPLE TOPS:

Viola 4359-66, rotary total depth.

Spoke Drill from 3626-45, open 20 minutes, recovered 60' mud.
Set 5 1/2" at 4362 with 250 casing. Drilled plug and drilled deeper to 4372. Swabbed 2 barrels oil and 1 barrel water per hour. Acidized with 500 gallons. Flowed 34 barrels oil plus 5 barrels water/14 hours. Total Depth 4397. Flowing 22 barrels oil/7 hours. Physical potential 70 barrels oil per day plus 51 water.

PLUGGING
FILE SEC 17 T 31 R 14
BOOK PAGE 22 LINE 6

STATE OF KANSAS)
COUNTY OF SEDGWICK) SS

RECEIVED
STATE COMMISSION
MAY 28 1953
5-28-53
CONSERVATION DIVISION
Wichita, Kansas

I, Edward A. Huffman, hereby certify that the above is a true and correct copy of the log of the No. 2 Shinner #00, located in the Northeast Quarter of the Northeast Quarter of the Southwest Quarter (NW 1/4 SW) of Section Seventeen (17), Township Thirty-one (31) South, Range Fourteen (14) West, Harbor County, Kansas.

Edward A. Huffman
Edward A. Huffman, District Manager
J. N. HUBER CORPORATION
June 7, 1949
Dorothy J. Kenee
Notary Public

Subscribed and sworn to before me this 7 day of June, 1949.

NOTARY PUBLIC
My Commission Expires January 26, 1953