


WELL PLUGGING RECORD

Give All Information Completely  
Make Required Affidavit  
Mail or Deliver Report to:  
Conservation Division  
State Corporation Commission  
800 Biting Building  
Wichita, Kansas

NORTH

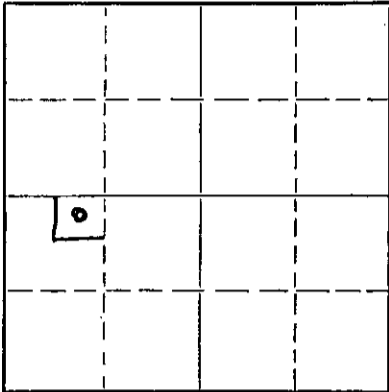

Locate well correctly on above Section Plat

Barber County, Sec. 17 Twp. 31 Rge. 14 (E) W (W)  
Location as "NE/CNW/SW" or footage from lines NE NW SW  
Lease Owner Leslie Oil Company  
Lease Name Skinner "H" Well No. 2  
Office Address Ward Parkway Bank Bldg., Kansas City, Missouri  
Character of Well (completed as Oil, Gas or Dry Hole) Oil  
Date well completed 10/15/48 1956  
Application for plugging filed January 13 1956  
Application for plugging approved January 14 1956  
Plugging commenced January 25 1956  
Plugging completed January 31 1956  
Reason for abandonment of well or producing formation Production had decreased to a Non-Commercial amount.

If a producing well is abandoned, date of last production January 4 1956  
Was permission obtained from the Conservation Division or its agents before plugging was commenced? Yes

Name of Conservation Agent who supervised plugging of this well M.A. Rives, Pratt, Kansas  
Producing formation Viola Depth to top 4410 Bottom 4444 Total Depth of Well 4444 Feet  
Show depth and thickness of all water, oil and gas formations.

OIL, GAS OR WATER RECORDS

CASING RECORD

FORMATION	CONTENT	FROM	TO	SIZE	PUT IN	PULLED OUT
Surface Pipe		Ground	840'	10"	840'	Left in hole
Viola	Oil	4410	4444	5 1/2"	4438	3484

Describe in detail the manner in which the well was plugged, indicating where the mud fluid was placed and the method or methods used in introducing it into the hole. If cement or other plugs were used, state the character of same and depth placed, from \_\_\_\_\_ feet to \_\_\_\_\_ feet for each plug set.

Filled bottom of hole with sand, from 4444' up to 4400. By dump bailor, set about 35' of cement. Lost Bailor in hole. Let plug set for 40 Hours. Top of cement plug about 4365. Shot pipe at about 3500'. Pulled pipe to about 2200'. Mixed and circulated 60 sacks of Gel Mud, by pump. After mud equalized, finished pulling pipe. Set rock plug with 20 sacks of cement at 300'. Top plug is cement from ground to 35'.

(If additional description is necessary, use BACK of this sheet)  
Name of Plugging Contractor West Supply Company  
Address Chase, Kansas

STATE OF KANSAS, COUNTY OF RENO, ss.  
Ben K. Kelly (employee of owner) of the above-described well, being first duly sworn on oath, says: That I have knowledge of the facts, statements, and matters herein contained and the log of the above-described well as filed and that the same are true and correct. So help me God.

(Signature) Ben K. Kelly, Prod. Supt.

SUBSCRIBED AND SWORN to before me this 9th day of February, 1956

Vera Kennedy, Notary Public.

My commission expires June 11, 1958

PLUGGING  
FILE SEC 17 T 31 R 14 W  
BOOK PAGE 31 LINE 17

FEB 10 1956  
2-10-56  
DIVISION  
Wichita, Kansas

15-007-10183-0000  
DRILLER'S LOG

COMPANY: J. M. HUBER CORPORATION  
 CONTRACTOR: J. M. HUBER CORPORATION  
 FARM NAME: NO. 2 SKINNER "H"

LOCATION: NE NW SW, 17-31S-14W  
 Barber County, Kansas

COMMENCED: 9-1-48  
 COMPLETED: 10-15-48

ELEVATION: 1697  
 PRODUCTION: 1785 barrels oil plus 30% water.

CASING USED: 10" at 840' with 500 sacks.  
 5 1/2" at 4438' with 200 sacks.

Red Bed & Shells	550
Shells & Red Bed	840
Shale, Shells & Red Bed	1075
Salt Shale & Shells	1275
Salt, Lime & Shale Breaks	1645
Shale & Shells	1775
Lime & Shale Breaks	1935
Lime & Shale	2020
Lime	2120
Lime & Shale	2220
Cherty Lime	2245
Shale & Lime	2300
Lime & Shale	3160
Lime & Shale Streaks	3210
Lime & Shale	3470
Brown Lime Sandy	3585
Lime & Shale	3680
Lime	3740
Lime & Shale	3850
Lime	3890
Lime & Shale	3985
Lime	4045
Lime & Shale	4083
Lime	4204
Lime & Shale	4365
Shale & Lime	4400
Lime & Shale	4430
Lime	4440
Rotary Total Depth	4440

SAMPLE TOPS:

Top Lansing 3841  
 Viola 4408c

5 1/2" at 4438' with 200 sacks. Drilled cement and drilled deeper to 4444, total depth and swabbed 3 1/2-4 barrels per hour/8 hours, natural, Filled up with 2200' oil in hole/20 hours. Acidized with 1000 gallons and swabbed 275 barrels oil/13 hours. Flowed 27 barrels oil per hour/8 hours through 1" choke; 24.86 barrels oil per hour/8 hours through 45/64" choke and 27.22 barrels oil per hour/1 hour through 1" choke. Bottom hole bomb potential-- 1785 barrels oil plus 30% water. Bottom Hole Pressure 640#. COMPLETE.

STATE OF KANSAS )  
 ) SS  
 COUNTY OF SEDGWICK )

I, Edward A. Huffman, hereby certify that the above is a true and correct copy of the log of the Skinner "H" #2, located in the Northeast Quarter of the Northwest Quarter of the Southwest Quarter (NE NW SW) of Section Seventeen (17), Township Thirty-one (31) South, Range Fourteen (14) West, Barber County, Kansas.

*Edward A. Huffman*  
 Edward A. Huffman, District Manager  
 J. M. HUBER CORPORATION

Subscribed and sworn to before me this 10 day of May, 1949.

*Dorothy J. Reeves*  
 Notary Public

My Commission expires January 26, 1953.

1-14-56

PLUGGING  
 NE 1/4 17 T 31 R 14W  
 BARBER COUNTY KANSAS