


WELL PLUGGING RECORD

Give All Information Completely  
Make Required Affidavit  
Mail or Deliver Report to:  
Conservation Division  
State Corporation Commission  
800 Bitting Building  
Wichita, Kansas

NORTH

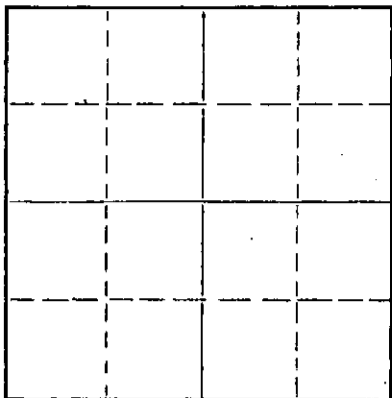

Locate well correctly on above  
Section Plat

Barber

County. Sec. 17 Twp. 31S Rge. 14W (E) (W)

Location as "NE/CNW&SW&" or footage from lines C WL NW NW  
Lease Owner Leslie Oil Company  
Lease Name Skinner Well No. 1  
Office Address 1546 Guinotte - Kansas City, Missouri  
Character of Well (completed as Oil, Gas or Dry Hole) Gas  
Date well completed March 23, 19 44  
Application for plugging filed April 15, 19 55  
Application for plugging approved April 18, 19 55  
Plugging commenced April 28 19 55  
Plugging completed May 7 19 55  
Reason for abandonment of well or producing formation Non-commercial

If a producing well is abandoned, date of last production Approx. March 15, 19 55  
Was permission obtained from the Conservation Division or its agents before plugging was commenced? Yes

Name of Conservation Agent who supervised plugging of this well Merle Rives  
Producing formation Viola Depth to top 4357 Bottom 4374 Total Depth of Well 4627 Feet  
Show depth and thickness of all water, oil and gas formations.

OIL, GAS OR WATER RECORDS

CASING RECORD

| FORMATION | CONTENT | FROM | TO | SIZE    | PUT IN | PULLED OUT |
|-----------|---------|------|----|---------|--------|------------|
|           |         |      |    | 10-3/4" | 283'   | None       |
|           |         |      |    | 8-5/8"  | 1083'  | 625'       |
|           |         |      |    | 5-1/2"  | 4595'  | 3064'      |
|           |         |      |    |         |        |            |
|           |         |      |    |         |        |            |
|           |         |      |    |         |        |            |

Describe in detail the manner in which the well was plugged, indicating where the mud fluid was placed and the method or methods used in introducing it into the hole. If cement or other plugs were used, state the character of same and depth placed, from \_\_\_\_\_ feet to \_\_\_\_\_ feet for each plug set.

A Lane Wells plug was set at 4400' and hole was filled with cement to 4398'. Casing was perforated at 4357'. Mixed 8 sacks of mud and circulated casing with same. Set a plug at 4100' and ran 5 sacks of cement. Bailed the hole after circulating casing with 22 sacks of jell mud. Set a rock bridge at 310' to 300' and ran 40 sacks of cement. Mudded the hole to 25' and ran 10 sacks of cement. Plugging completed.

Name of Plugging Contractor West Supply Co., Inc. (If additional description is necessary, use BACK of this sheet)  
Address Chase, Kansas

STATE OF Kansas COUNTY OF Finney, ss.

Ben L. Kelley (employee of owner) or Conservation Division of the above-described well, being first duly sworn on oath, says: That I have knowledge of the facts, statements, and matters herein contained and the log of the above-described well as filed and that the same are true and correct. So help me God.

(Signature) Ben L. Kelley  
P. O. Box 459, Garden City, Kansas (Address)

SUBSCRIBED AND SWORN TO before me this 17th day of May, 19 55

My commission expires December 10, 1958

[Signature] Notary Public.

RECEIVED  
STATE CORPORATION COMMISSION  
PLUGGING  
MAY 19 1955  
5-18-55  
CONSERVATION DIVISION  
Wichita, Kansas

WELL LOG

Skinner Well No. 1  
 CWL NW NW Section 17-31S-14W  
 Barber County, Kansas  
 Surface Elevation: 1653'

Rotary - Started: 1-14-44                      Completed: 3-5-44  
 Cable - Started: 3-5-44                      Completed: 3-23-44

Set 10 3/4" Casing at 283' with 225 sacks cement  
 Set 8 5/8" Casing at 1083' with 34 sacks cement  
 Set 5 1/2" Casing at 4595' with 200 sacks cement

|                       |      |      |                |      |      |
|-----------------------|------|------|----------------|------|------|
| S. clay & sand        | 0    | 50   | shale          | 2805 | 2835 |
| shale and shells      | 50   | 190  | lime           | 2835 | 2845 |
| R. shale and shells   | 190  | 225  | lime and shale | 2845 | 2988 |
| sand                  | 225  | 235  | lime           | 2988 | 3484 |
| shale and Red beds    | 235  | 340  | shale and lime | 3484 | 3518 |
| red bed and shells    | 340  | 470  | lime           | 3518 | 3599 |
| shale and shells      | 470  | 940  | lime and shale | 3599 | 3615 |
| shale and lime shells | 940  | 1080 | lime show gas  | 3615 | 3626 |
| shale ans shells      | 1080 | 1705 | lime           | 3626 | 3659 |
| anhydrite             | 1705 | 1723 | shaly sand     | 3659 | 3720 |
| lime and shale        | 1723 | 1750 | shale and lime | 3720 | 3804 |
| shale and salt        | 1750 | 1795 | lime           | 4804 | 4098 |
| shells and shale      | 1795 | 1816 | chert and lime | 4098 | 4118 |
| broken lime           | 1816 | 1830 | lime           | 4118 | 4246 |
| lime and gyp          | 1830 | 1859 | lime and shale | 4246 | 4275 |
| lime                  | 1859 | 1915 | lime and chert | 4275 | 4298 |
| lime and shale        | 1915 | 2132 | shale and lime | 4298 | 4362 |
| lime                  | 2132 | 2142 | lime           | 4362 | 4403 |
| shale, lime ans shell | 2142 | 2185 | lime and chert | 4403 | 4430 |
| lime                  | 2185 | 2235 | lime           | 4430 | 4460 |
| lime and shale        | 2235 | 2290 | lime and chert | 4460 | 4512 |
| shale                 | 2290 | 2330 | shale          | 4512 | 4522 |
| shale and lime        | 2330 | 2345 | sand and shale | 4522 | 4531 |
| lime                  | 2345 | 2395 | sand and lime  | 4531 | 4539 |
| lime and shale        | 2395 | 2618 | shale and sand | 4539 | 4580 |
| shale blk.            | 2618 | 2640 | shale and lime | 4580 | 4613 |
| lime                  | 2640 | 2670 | lime           | 4613 | 4627 |
| shale and lime        | 2670 | 2805 | Total depth    | 4627 |      |

Plugged back 3-4 Lane-Wells plug top @ 4548.5'  
 rock and cement 4548.5' to 4527.2'  
 3-13 Lane-Wells plug @ 4484.6'  
 rock to 4483.1'  
 3-16 Lane-Wells plug at 4401'  
 3-23 Cement to 4398'

Certificate

I, Ben L. Kelley, Production Superintendent of the Shallow Water Refining Company, do certify that to the best of my knowledge and belief, the above is a true and correct log of the Skinner Well No. 1, located CWL NW NW Section 17-31S-14W, Barber County, Kansas

Ben L. Kelley

Subscribed and sworn to before me, in and for the County of Finney, State of Kansas, this 15th day of April, 1955.

[Signature]  
 Notary Public  
 THE STATE OF KANSAS COMMISSION

My Commission Expires December 10, 1958.

**PLUGGING**  
 FILE SEC 17 T 31 R 4 W  
 BOOK PAGE 111 LINE 32

APR 16 1955  
 4-16-55  
 CONSERVATION DIVISION  
 Wichita, Kansas