


15-007-00283-0000

STATE OF KANSAS
STATE CORPORATION COMMISSION

WELL PLUGGING RECORD

Give All Information Completely
Make Required Affidavit
Mail or Deliver Report to:
Conservation Division
State Corporation Commission
800 Bitting Building
Wichita, Kansas

NORTH

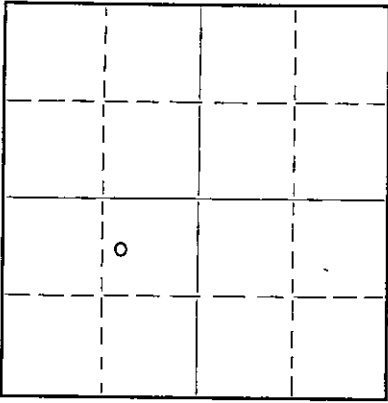

Locate well correctly on above
Section Plat

Barber County, Sec. 16, Twp. 31, Rge. 14, ~~75X~~ (W)
Location as "NE/CNW $\frac{1}{4}$ SW $\frac{1}{4}$ " or footage from lines C. W $\frac{1}{2}$, NE $\frac{1}{2}$, SW $\frac{1}{4}$
Lease Owner The Drillers Gas Company
Lease Name H. W. Skinner Well No. B. 1
Office Address 903 Union National Bank Bldg.
Character of Well (completed as Oil, Gas or Dry Hole) Gas Well
Date well completed September 6 1945
Application for plugging filed December 15 1949
Application for plugging approved January 3 1950
Plugging commenced December 16 1949
Plugging completed December 23 1949
Reason for abandonment of well or producing formation
Ceased producing gas
If a producing well is abandoned, date of last production November 29 1949
Was permission obtained from the Conservation Division or its agents before plugging was commenced? Yes

Name of Conservation Agent who supervised plugging of this well C. D. Stough
Producing formation Maquoketa Depth to top 4,363 Bottom Total Depth of Well 4412 Feet
Show depth and thickness of all water, oil and gas formations.

OIL, GAS OR WATER RECORDS

CASING RECORD

Formation	Content	From	To	Size	Put In	Pulled Out
Maquoketa - Viola		4363	4412	8-5/8" 5-1/2"	823' 4366'	0 2874'

Describe in detail the manner in which the well was plugged, indicating where the mud fluid was placed and the method or methods used in introducing it into the hole. If cement or other plugs were used, state the character of same and depth placed, from _____ feet to _____ feet for each plug set.

Filled hole with chat to 3366'. Dumped 5 sacks of cement at 3350'.
Shot pipe off at 2874'. Pulled pipe and mudded hole to 250'. Dumped
15 sacks of cement at 250'. Finished mudding hole and dumped 10 sacks
of cement at top of surface.

1-9-50
JAN 9 1950
SIX

(If additional description is necessary, use BACK of this sheet)

Correspondence regarding this well should be addressed to The Drillers Gas Company
Address 903 Union National Building, Wichita 2, Kansas

STATE OF KANSAS, COUNTY OF SEDGWICK, ss.

M. R. Schwartzkopf (employee of owner) or (owner or operator) of the above-described well,
being first duly sworn on oath, says: That I have knowledge of the facts, statements, and matters herein contained and the log of the above-
described well as filed and that the same are true and correct. So help me God.

(Signature) *M. R. Schwartzkopf*
903 Union National Bank Bldg., Wichita 2, Kansas
(Address)

SUBSCRIBED AND SWORN TO before me this 6th day of January, 1950.

Bertha P. Wilson

My commission expires August 13, 1951

Notary Public.

PLUGGING
FILE SEC. 16 T. 31 R. 14
BOOK PAGE 132 LINE 12

WELL LOG BUREAU KANSAS GEOLOGICAL SOCIETY
412 Union National Bk. Bldg., Wichita, Kansas

Company - DRILLERS GAS CO.
Farm H.W. Skinner "B" No. 1.

SEC. 16 T. 31 R. 14 W
Q1/2 NE SW

Total Depth. 4385.
Comm 7-23-45 Comp. 9-6-45
Shot or Treated. 1000 gal acid.
Contractor. R.C. Patton Co.
issued. 1-12-46

County. Barber
KANSAS



Elevation.

Production. Gauge 7,135,000 G

CASING:

8 5/8" 823' Cem.
5 1/2" 4366' Cem.

Figures Indicate Bottom of Formations.

sand & rock	50
red bed	510
anhydrite & shale	535
shale & shells	610
red bed	1235
shale & shells	1400
salt & shale	1520
shale shells	1610
lime & shale	2195
sand hrd	2205
lime & shale	2275
lime	2305
lime & shale	2610
lime & shells	2660
lime & shale	2905
lime & shells	2945
lime & shale	2988
lim.	3225
lime sft	3516
lime & shale	3608
shale & shells	3748
shale	3772
lime	3813
shale & shells	3904
lime	4066
lime & chert	4083
cherty lime	4096
lime chat	4127
lime	4290
shale	4362
lime	4385
Total Depth	

Top of Viola 4363

RECEIVED
CS 1-16-50
JAN 16 1950
STATE COMMISSION
KANSAS

PLUGGING
FILE SEC 16 T 31 R 14 W
PAGE 172 LINE 12