


15-007-10201-0000

WELL PLUGGING RECORD

Give All Information Completely  
Make Required Affidavit  
Mail or Deliver Report to:  
Conservation Division  
State Corporation Commission  
800 Bitting Building  
Wichita, Kansas

NORTH

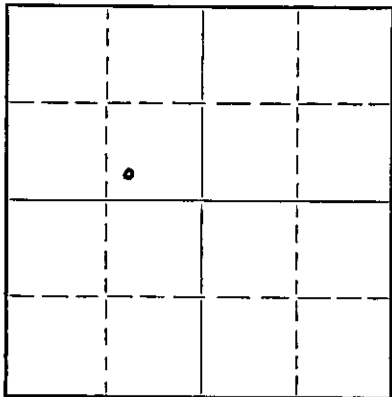

Locate well correctly on above  
Section Plat

Barber

County. Sec. 29 Twp. 31 Rge. 14 ~~E~~ W (W)

Location as "NE/CNW<sup>1</sup>/<sub>4</sub>SW<sup>1</sup>/<sub>4</sub>" or footage from lines SW NE NW <sup>1</sup>/<sub>4</sub> 9.65 from 712-1675-201

Lease Owner Deep Rock Oil Corporation

Lease Name H.W. Skinner "B"

Well No. 6

Office Address Box 1051, Tulsa, Oklahoma

Character of Well (completed as Oil, Gas or Dry Hole) Oil

Date well completed April 27 19 48

Application for plugging filed October 3 19 50

Application for plugging approved October 5 19 50

Plugging commenced October 19 19 50

Plugging completed October 23 19 50

Reason for abandonment of well or producing formation Well not producing oil  
in paying quantities

If a producing well is abandoned, date of last production November 15 19 49

Was permission obtained from the Conservation Division or its agents before plugging was commenced? Yes

Name of Conservation Agent who supervised plugging of this well C.D. Stough

Producing formation Viola Lime Depth to top 4534' Bottom 4544' Total Depth of Well 4544 Feet

Show depth and thickness of all water, oil and gas formations.

OIL, GAS OR WATER RECORDS

CASING RECORD

Formation	Content	From	To	Size	Put In	Pulled Out
				10 3/4"	898'	None
				7"	4536'	3181'

Describe in detail the manner in which the well was plugged, indicating where the mud fluid was placed and the method or methods used in introducing it into the hole. If cement or other plugs were used, state the character of same and depth placed, from \_\_\_\_\_ feet to \_\_\_\_\_ feet for each plug set.

Filled hole with mud from 4544' to 4400'. Ran 6 sacks cement from 4400' to 4365'. Filled hole with mud to 260'. Set rock bridge from 260' to 250'. Run 20 sacks cement from 250' to 210'. Filled with mud from 210' to 20'. Ran 10 sacks of cement from 20' which filled hole to top of hole and in cellar.

(If additional description is necessary, use BACK of this sheet)

Correspondence regarding this well should be addressed to Deep Rock Oil Corporation

Address Box 429, Hutchinson, Kansas

STATE OF Kansas, COUNTY OF Reno, ss.

Jack Smith

(employee of owner) or (conservation division)

being first duly sworn on oath, says: That I have knowledge of the facts, statements, and matters herein contained and the log of the above-described well as filed and that the same are true and correct. So help me God.

(Signature) Jack Smith

Box 429, Hutchinson, Kansas

(Address)

SUBSCRIBED AND SWORN to before me this 6 day of November, 19 50

*[Signature]*

STATE CORPORATION COMMISSION Notary Public.

My commission expires November 26-1951

23-5091-S 8-50-10M

PLUGGING  
FILE SEC 29 T 31 R 14 W  
BOOK PAGE 37 LINE 37

NOV 8 - 1950  
11-8-50  
CONSERVATION DIVISION  
Wichita, Kansas

15-007-10201-0000

H.W. Skinner B6 - SE-NE-NU  
965' from N. Line  
1675' from W. Line  
Sec. 29, Twp. 31S, Rge. 14W  
Barber County, Kansas

0	200	Red Bed
200	250	Water Sand
250	690	Red Bed
690	1650	Shale & Shells
1650	1750	Salt
1750	1830	Shale & Salt
1830	2035	Lime & shale
2035	2600	Lime
2600	2900	Lime & Shale
2900	3050	Shale
3050	3305	Lime & Shale
3305	3690	Lime
3690	3745	Lime Broken
3745	3770	Lime & Shale
3770	3800	Shale
3800	3940	Lime & Shale
3940	4470	Lime
4470	4534	Lime & Shale
4534	4541	Viola Dolomite
4541	4544	Dolomite Cherty white
4544		Total Depth

Set 898' of 10 3/4" 32.75# New  
H-40 8 R thd Smls. Cemented with  
400sacks

Set 4635' of 7" 23# New J-55 8R thd  
Smls. Cemented with 200 sacks, 3%  
aquagel.

RECEIVED  
STATE CORPORATION COMMISSION

OCT 4 - 1950

CONTRACT NO. [ ]  
DATE [ ]

**PLUGGING**  
 FILE SEC 29 T 31 R 14W  
 BOOK PAGE 32 LINE 37