

STATE CORPORATION COMMISSION OF KANSAS
OIL & GAS CONSERVATION DIVISION
WELL COMPLETION OR RECOMPLETION FORM
ACO-1 WELL HISTORY
DESCRIPTION OF WELL AND LEASE

Operator: License # 4629
Name Brito Oil Company, Inc.
Address 200 E. First, Suite 413
City/State/Zip Wichita, KS 67202

Purchaser Oil: Conoco
Gas: Williams Companies

Operator Contact Person Raul F. Brito
Phone 316-263-8787

Contractor: License # 5418
Name Allen Drilling Company

Wellsite Geologist Raul Brito
Phone

Designate Type of Completion
 New Well Re-Entry Workover

Oil SWD Temp Abd
 Gas Inj Delayed Comp.
 Dry Other (Core, Water Supply etc.)

If ONWO: old well info as follows:
Operator
Well Name
Comp. Date Old Total Depth

WELL HISTORY

Drilling Method:
 Mud Rotary Air Rotary Cable
6-1-87 6-13-87 7-12-87
Spud Date Date Reached TD Completion Date
4910' None
Total Depth PBDT

Amount of Surface Pipe Set and Cemented at 251 feet
Multiple Stage Cementing Collar Used? Yes No
If yes, show depth set feet
If alternate 2 completion, cement circulated
from feet depth to SX cmt
Cement Company Name BJ Titan
Invoice # TR 064


API NO. 15-007-22-152-00-00
County Barber
SW NE NE Sec. 31 Twp 33 Rge. 11 East
X West

4290 Ft North from Southeast Corner of Section
990 Ft West from Southeast Corner of Section
(Note: Locate well in section plat below)

Lease Name Newkirk "A" Well # 2
Field Name Rhoades South
Producing Formation Mississippi

Elevation: Ground 1419' 1424' KB

Section-Plat

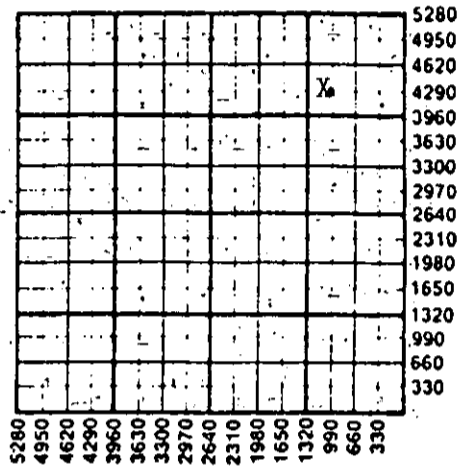

WATER SUPPLY INFORMATION

Disposition of Produced Water: Disposal
Docket # Repressuring

Questions on this portion of the ACO-1 call:
Water Resources Board (913) 296-3717


Source of Water:
Division of Water Resources Permit #
 Groundwater.....Ft North from Southeast Corner
(Well)Ft West from Southeast Corner of
Sec Twp Rge East West
 Surface Water.....Ft North from Southeast Corner
(Stream, pond etc).....Ft West from Southeast Corner
Sec Twp Rge East West
 Other (explain).....
(purchased from city, R.W.D. #)

INSTRUCTIONS: This form shall be completed in triplicate and filed with the Kansas Corporation Commission, 200 Colorado Derby Building, Wichita, Kansas 67202, within 120 days of the spud date of any well. Rule 82-3-130, 82-3-107 and 82-3-106 apply. Information on side two of this form will be held confidential for a period of 12 months if requested in writing and submitted with the form. See rule 82-3-107 for confidentiality in excess of 12 months. One copy of all wireline logs and drillers time log shall be attached with this form. Submit CP-4 form with all plugged wells. Submit CP-111 form with all temporarily abandoned wells.

All requirements of the statutes, rules and regulations promulgated to regulate the oil and gas industry have been fully complied with and the statements herein are complete and correct to the best of my knowledge.

Signature
Title President Date 7/23/87

Subscribed and sworn to before me this 24th day of July 1987
Notary Public
Date Commission Expires

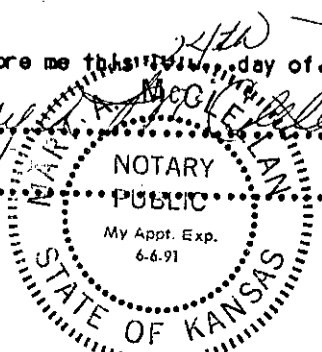

K.C.C. OFFICE USE ONLY
F Letter of Confidentiality Attached
C Wireline Log Received
C Drillers Timelog Received
Distribution
 KCC SWD/Rep NGPA
 KGS Plug Other
(Specify)

Operator Name Brito Oil Company, Inc. Lease Name Newkirk "A" Well # 2

Sec. 31 Twp. 33 Rge. 11 East West County Barber

WELL LOG

INSTRUCTIONS: Show important tops and base of formations penetrated. Detail all cores. Report all drill stem tests giving interval tested, time tool open and closed, flowing and shut-in pressures, whether shut-in pressure reached static level, hydrostatic pressures, bottom hole temperature, fluid recovery, and flow rates if gas to surface during test. Attach extra sheet if more space is needed. Attach copy of log.

Drill Stem Tests Taken	<input checked="" type="checkbox"/> Yes	<input type="checkbox"/> No	Formation Description <input checked="" type="checkbox"/> Log <input type="checkbox"/> Sample
Samples Sent to Geological Survey	<input checked="" type="checkbox"/> Yes	<input type="checkbox"/> No	
Cores Taken	<input type="checkbox"/> Yes	<input checked="" type="checkbox"/> No	
DST #11-4536-70/30-45-60-60/ Rec: 50' wm/GTS/75" Fp,s 20-20#, 31-13#. SIP,s 218-208#.			Heebner 3636
DST #2-4570-4600/30-45-60-60/GTS in 16". Stab @ 108MCFD/30". Rec 45' O&GCWM, 120"MCO and 360' CGO. FP's 104-116#, 135-229#. SIP's 935-935#			Lansing 3829
DST 3#-4600-20/30-45-60-60/GTS/5". Stab @12.7MCFD in 30". Rec: 150 GCM, 480 SW w/ oil specks and Viola 1380 SW. FP's 634-863#, 935-977#. SIP's 977-987#. RTD LTD			Stark 4293
DST #4-4840-64/30-45-30-45/ Rec: 70Mud, NS. FP's 31-31#, 41-41#. SIP's 1807-1674#.			Chero 4506
DST #5- (straddle) 4580-4603/30-45-60-60/ Rec; 365 Drilling Mud, NW. FP,s 156-156#,177-177# SIP's Invalid due to leaking packers.			Mississippi 4524
			Kinder 4725
			4844
			4910
			4906

CASING RECORD <input checked="" type="checkbox"/> New <input type="checkbox"/> Used Report all strings set-conductor, surface, intermediate, production, etc.							
Purpose of String	Size Hole Drilled	Size Casing Set (In O.D.)	Weight Lbs/Ft.	Setting Depth	Type of Cement	#Sacks Used	Type and Percent Additives
Surface	12 1/4	8 5/8	20#	251	60/40 Poz	175	3% cc
Production		4 1/2	10 1/2	4723	Surefill 7 1/2# Gilsomite	150	
PERFORATION RECORD				Acid, Fracture, Shot, Cement Squeeze Record			
Shots Per Foot	Specify Footage of Each Interval Perforated			(Amount and Kind of Material Used)		Depth	
3/ft	4604-05			Squeeze w/ 150 SX Class A			
4/ft	4590-94			Acid w/ 500 gal 15% HCL MCA acid.			
TUBING RECORD		Size 2 3/8"	Set At 4623	Packer at None	Liner Run	<input type="checkbox"/> Yes <input checked="" type="checkbox"/> No	
Date of First Production	Producing Method						
7-14-1987	<input type="checkbox"/> Flowing <input checked="" type="checkbox"/> Pumping <input type="checkbox"/> Gas Lift <input type="checkbox"/> Other (explain).....						
Estimated Production Per 24 Hours	Oil	Gas	Water	Gas-Oil Ratio	Gravity		
	15 Bbls	50 MCF	60 Bbls	3300 CFPB	20.5		

METHOD OF COMPLETION

Production Interval

Disposition of gas: Vented Sold Used on Lease Open Hole Perforation Other (Specify)..... 4590-4595

Dually Completed Commingled