


WELL PLUGGING RECORD

Give All Information Completely
Make Required Affidavit
Mail or Deliver Report to:
Conservation Division
State Corporation Commission
211 No. Broadway
Wichita, Kansas

Barber County, Sec. 8 Twp. 33S Rge. 11W (E) (W)

Location as "NE/CNW/SW" or footage from lines SW SW
Lease Owner SINCLAIR OIL & GAS COMPANY
Lease Name W. A. NEWKIRK Well No. 10
Office Address P. O. BOX 521 - TULSA, OKLAHOMA 67530
Character of Well (completed as Oil, Gas or Dry Hole) GAS
Date well completed FEBRUARY, 19 55
Application for plugging filed JANUARY, 21, 19 64
Application for plugging approved JANUARY, 22, 19 64
Plugging commenced APRIL 29, 19 64
Plugging completed MAY 3, 19 64
Reason for abandonment of well or producing formation Water has gradually encroached toward well, Gas has depleted from zone.
If a producing well is abandoned, date of last production JUNE, 19 62
Was permission obtained from the Conservation Division or its agents before plugging was commenced? YES

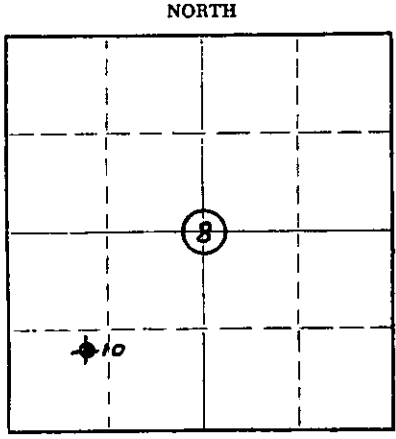

Locate well correctly on above Section Plat

Name of Conservation Agent who supervised plugging of this well MR. ARCHIE ELVING - PRATT, KANSAS
Producing formation DOUGLAS Depth to top 3624' Bottom 3705' Total Depth of Well 4525 Feet
Show depth and thickness of all water, oil and gas formations.

OIL, GAS OR WATER RECORDS

CASING RECORD

FORMATION	CONTENT	FROM	TO	SIZE	PUT IN	PULLED OUT
DOUGLAS SAND	Gas	3624'	3705'	10-3/4"	235'	None
				5-1/2"	4522'	3192'

Describe in detail the manner in which the well was plugged, indicating where the mud fluid was placed and the method or methods used in introducing it into the hole. If cement or other plugs were used, state the character of same and depth placed, from _____ feet to _____ feet for each plug set.

Set Wooden Plug at 3360'. Dumped Sand from 3340'-3360' and dumped 5 sacks of cement from 3305'-3340'. Shot off 5-1/2"OD Casing 3198'. Pulled pipe loose. Mixed and pumped 70 sacks of Jel. Pulled 19 joints of casing to 2605'. Spotted 75 sacks of regular cement from 2300'-2605'. Pulled 41 joints of casing. Pulled 42 joints of 5-1/2"OD casing for a total of 102 joints(3192') recovered. Squeezed Surface Casing with 150 sacks regular cement. Max. Pressure 450#, Min. Pressure 200#. Dumped 5 sacks of cement in Surface casing at top of hole. Completed P&A of Gas Well, May 3, 1964, per instructions from Mr. Archie Elving, State Plugging Agent.

RECEIVED
STATE CORPORATION COMMISSION
MAY 11 1964

(If additional description is necessary, use BACK of this sheet)
Name of Plugging Contractor KNIGHT CASING PULLING COMPANY
Address CHASE, KANSAS 67524
CONSERVATION DIVISION
Wichita, Kansas

STATE OF KANSAS, COUNTY OF BARBER, ss.
J. F. DONHAM (employee of owner) or (owner or operator) of the above-described

well, being first duly sworn on oath, says: That I have knowledge of the facts, statements, and matters herein contained and the log of the above-described well as filed and that the same are true and correct. So help me God.

(Signature) J. F. Donham
ROUTE #1 - GREAT BEND, KANSAS 67530
(Address)

SUBSCRIBED AND SWORN to before me this 8TH day of MAY, 19 64

My commission expires JULY 12, 1967
Notary Public.

COPY


WELL LOG BUREAU—KANSAS GEOLOGICAL SOCIETY
508 East Murdock, Wichita, Kansas

Company- SINCLAIR OIL & GAS CO.
Farm- W. A. Newkirk No. 10

SEC. 8 T. 33 R. 11W
NE SW SW

Total Depth. 4525
Comm. 1-25-55 Comp. 2-10-55
Shot or Treated.
Contractor. Graham-Messman-Rinehart Oil Co.
issued. 1-7-56

County Barber
KANSAS

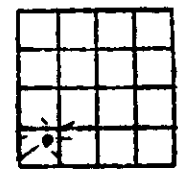

CASING:
10 3/4 @ 235' w/ 200 sx cmt.
5 1/2 @ 4525' w/ 250 sx cmt.

Elevation. 1415

Production. 9,000,000 CFHPD

Figures indicate Bottom of Formations

clay	38
clay, native stone & shale	235
shale	237
shale & shells	1055
shale	1610
shale & lime	1770
Ft. Riley lime	1929
shale & lime	3634
Douglas sand	3646
coring: Douglas	3670
sand, shale & lime	3715
Topeka lime	3815
lime	3916
K. C. lime	3973
lime	4411
Coring: Mississippi	4463
Mississippi	4525
Total Depth	
SCOUT TOPS:	
Douglas sand	3627
Lansing	3728
Mississippi	4384

RECEIVED
STATE CORPORATION COMMISSION
JUL 16 1964
CONSERVATION DIVISION
Wichita, Kansas