


STATE OF KANSAS
STATE CORPORATION COMMISSION

Form CP-4

WELL PLUGGING RECORD

Give All Information Completely
Make Required Affidavit
Mail or Deliver Report to:
Conservation Division
State Corporation Commission
212 No. Market
Wichita, Kansas 67202

NORTH

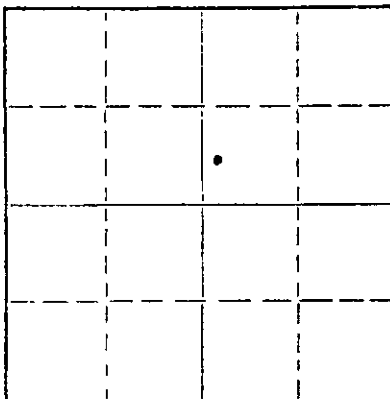

Locate well correctly on above
Section Plat

Barber County, Sec. 8 Twp. 33 Rge. 11 (E) 11 (W)
Location as "NE/CNW&SW" or footage from lines W/2 SW NE
Lease Owner Atlantic Richfield Company
Lease Name W. A. Newkirk Well No. 11
Office Address Box 521, Tulsa, Oklahoma
Character of Well (completed as Oil, Gas or Dry Hole) oil
Date well completed _____ 19____
Application for plugging filed November 2 19 71
Application for plugging approved _____ 19____
Plugging commenced November 4 19 71
Plugging completed November 6 19 71
Reason for abandonment of well or producing formation depleted

If a producing well is abandoned, date of last production _____ 19____
Was permission obtained from the Conservation Division or its agents before plugging was commenced? yes

Name of Conservation Agent who supervised plugging of this well G. R. Biberstein
Producing formation _____ Depth to top _____ Bottom _____ Total Depth of Well 4440 Feet
Show depth and thickness of all water, oil and gas formations.

OIL, GAS OR WATER RECORDS

CASING RECORD

FORMATION	CONTENT	FROM	TO	SIZE	PUT IN	PULLED OUT
		0	250'	10 3/4"	250'	none
		0	3688'	4 1/2"	3688'	1765.80

Describe in detail the manner in which the well was plugged, indicating where the mud fluid was placed and the method or methods used in introducing it into the hole. If cement or other plugs were used, state the character of same and depth placed, from _____ feet to _____ feet for each plug set.

Sanded back to 4000' and dumped 4 sacks of cement.
Set 20' rock bridge at 250'. Plugged well with 6 yards of ready mix cement.

RECEIVED
STATE CORPORATION COMMISSION
NOV 18 1971
CONSERVATION DIVISION
Wichita, Kansas

Name of Plugging Contractor PIPE PULLERS, INC. (If additional description is necessary, use BACK of this sheet)
Address Box 486, Ellinwood, Kansas 67526

STATE OF KANSAS COUNTY OF BARTON, ss.
Evelyn Roth (employee of owner) or (owner or operator) of the above-described well, being first duly sworn on oath, says: That I have knowledge of the facts, statements, and matters herein contained and the log of the above-described well as filed and that the same are true and correct. So help me God.

(Signature) Evelyn Roth
Ellinwood, Kansas (Address)

SUBSCRIBED AND SWORN TO before me this 16th day of November, 1971
George A. Meyer
Notary Public.

My commission expires Feb. 10, 1975

W. A. Newkirk Oil and Co.

SEC. 8 T. 33S-11W

W. A. Newkirk No. 14

LOC. W/2-SWNE


TOTAL DEPTH 4440'

COUNTY Barber

COMM. 2-1-63

COMP. 2-16-63

CONTRACTOR Garvey Drilling Co.

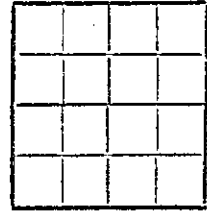

CASING 10 / 3/4" @ 250' w/200 SX

4 1/2" @ 3628' w/125 SX

ELEVATION

PRODUCTION

FIGURES INDICATE BOTTOM OF FORMATIONS

- 100' Red Bed
- 250' Shells, Sand, and Shale
- 467' Shale
- 1215' Shale and Shells
- 1690' Shale and Lime
- 2710' Lime and Shale
- 3000' Shale and Lime
- 3140' Lime and Shale
- 3290' Shale and Lime
- 3650' Lime and Shale
- 4293' Lime
- 4369' Lime and Shale
- 4405' Lime
- 4440' Mississippi Lime
- 4440' RTD

RECEIVED
 STATE CORPORATION COMMISSION
 NOV 3 1971
 CONSERVATION DIVISION
 Wichita, Kansas

State of Kansas }
 County of Barber } ss

I, Verne A. Morris of Garvey Drilling Company

upon oath state the above and foregoing is a true and correct copy of the log of the W. A. Newkirk #14 well.

Verne A. Morris

Subscribed and sworn to before me this 205h day of February 19 63

My Commission Expires: October 24th, 1966

Bransford
 NOTARY PUBLIC

