


Give All Information Completely
Make Required Affidavit
Mail or Deliver Report to:
Conservation Division
State Corporation Commission
800 Bittig Building
Wichita, Kansas

WELL PLUGGING RECORD

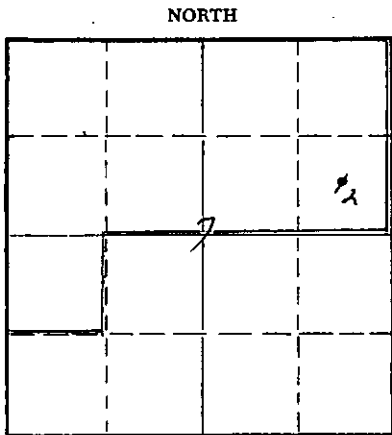

Locate well correctly on above Section Plat

Barber County, Sec. 7 Twp. 33S Rge. (E) 11 (W)
Location as "NE/CNW/SW" or footage from lines C SE/4 NE/4
Lease Owner Skelly Oil Company
Lease Name L. E. McClure Well No. 2
Office Address Box 1650, Tulsa, Oklahoma
Character of Well (completed as Oil, Gas or Dry Hole) Dry Hole
Date well completed April 9, 19 55
Application for plugging filed April 11, 19 55
Application for plugging approved April 12, 19 55
Plugging commenced April 9, 19 55
Plugging completed April 10, 19 55
Reason for abandonment of well or producing formation Dry Hole

If a producing well is abandoned, date of last production _____ 19 ____
Was permission obtained from the Conservation Division or its agents before plugging was commenced? Yes (Verbally)

Name of Conservation Agent who supervised plugging of this well Mr. M. A. Rives
Producing formation _____ Depth to top _____ Bottom _____ Total Depth of Well 4527 Feet
Show depth and thickness of all water, oil and gas formations.

OIL, GAS OR WATER RECORDS

CASING RECORD

FORMATION	CONTENT	FROM	TO	OD SIZE	PUT IN	PULLED OUT
Mississippi Lime	Dry	4400'	4527'	8-5/8"	351' 0"	None

Describe in detail the manner in which the well was plugged, indicating where the mud fluid was placed and the method or methods used in introducing it into the hole. If cement or other plugs were used, state the character of same and depth placed, from _____ feet to _____ feet for each plug set.

Mud laden fluid 4527' to 300'
20 sacks of cement 300' to 240'
Mud laden fluid 240' to 30'
Hulls, wood plug and 10 sacks of cement 30' to 5'
Surface soil 5' to 0'

APR 15 1955
CONSERVATION DIVISION
Wichita, Kansas

(If additional description is necessary, use BACK of this sheet)
Name of Plugging Contractor Claude Wentworth Drilling Co., Inc.
Address 2701 East 15th, Tulsa, Oklahoma

STATE OF Kansas, COUNTY OF Reno, ss.
H. E. Wamsley (employee of owner) of the above-described well, being first duly sworn on oath, says: That I have knowledge of the facts, statements, and matters herein contained and the log of the above-described well as filed and that the same are true and correct. So help me God.

(Signature) _____
Box 391, Hutchinson, Kansas
(Address)

SUBSCRIBED AND SWORN TO before me this 14th day of April, 1955

My commission expires April 7, 1959 _____
Notary Public.

PLUGGING
FILE SEC 7 T 33 R 11W
BOOK PAGE 110 LINE 36

