

WELL PLUGGING RECORD


Give All Information Completely
Make Required Affidavit
Mail or Deliver Report to:
Conservation Division
State Corporation Commission
211 No. Broadway
Wichita, Kansas

Barber

County. Sec. 14 Twp. 33 Rge. 11 (E) W (W)

Location as "NE/CNW/SW" or footage from lines
Lease Owner Sinclair Oil & Gas Company
Lease Name John Alfred Circle Well No. 2
Office Address Chase, Kansas
Character of Well (completed as Oil, Gas or Dry Hole) Oil
Date well completed 8-24-55 19
Application for plugging filed 3-18-59 19
Application for plugging approved 3-19-59 19
Plugging commenced 4-3-59 19
Plugging completed 4-8-59 19
Reason for abandonment of well or producing formation Unprofitable to operate.

NORTH

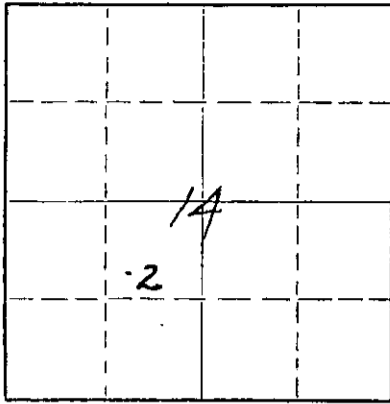

Locate well correctly on above
Section Plat

If a producing well is abandoned, date of last production 3-12-59 19
Was permission obtained from the Conservation Division or its agents before plugging was commenced? Yes

Name of Conservation Agent who supervised plugging of this well Fred Hample
Producing formation Miss. Depth to top 4552' Bottom 4558' Total Depth of Well 4632' Feet
Show depth and thickness of all water, oil and gas formations.

OIL, GAS OR WATER RECORDS

CASING RECORD

FORMATION	CONTENT	FROM	TO	SIZE	PUT IN	PULLED OUT
				10-3/4"	210'	None
				5-1/2"	4630'	3412'

Describe in detail the manner in which the well was plugged, indicating where the mud fluid was placed and the method or methods used in introducing it into the hole. If cement or other plugs were used, state the character of same and depth placed, from _____ feet to _____ feet for each plug set.

Checked hole to 4610' and found it open.
Had difficulty plugging off bottom, sand kept going away. Pushed plug to 4492' and ran 5 sacks of cement on top of plug.
Pulled 5 1/2" casing, cleared hole and bailed hole to 245', set rock bridge to 235' and ran 25 sacks of cement. Mudded the hole to 40', set 10' rock bridge and ran 15 sacks cement to base of cellar

RECEIVED
STATE CORPORATION COMMISSION
APR 15 1959
CONSERVATION
Wichita, Kansas

(If additional description is necessary, use BACK of this sheet)
Name of Plugging Contractor West Supply Co., Inc.
Address Chase, Kansas

STATE OF KANSAS, COUNTY OF RICE, ss.
I, W. B. Rhees (employee or owner) or (owner or operator) of the above-described well, being first duly sworn on oath, says: That I have knowledge of the facts, statements, and matters herein contained and the log of the above-described well as filed and that the same are true and correct. So help me God.

(Signature) W B Rhees
P.O. Box 466, Chase, Kansas
(Address)

SUBSCRIBED AND SWORN to before me this 13th day of April, 19 59

My commission expires 8-13-62
L B Reynolds Notary Public.

PLUGGING
FILE SEC 14 T. 33 R. 11 W
BOOK PAGE 23 LINE 10

WELL LOG BUREAU—KANSAS GEOLOGICAL SOCIETY
508 East Mardock, Wichita, Kansas

COPY


SINCLAIR OIL & GAS COMPANY
Company—
Farm—John Alfred Circle No. 2

SEC. 14 T. 33 R. 11W
SW NW SW
330' E of WL, 990' S of NL

Total Depth. 4632
Comm. 7-29-55 Comp. 7-18-55
Shot or Treated.
Contractor. Brack Drilling Co., Inc.
Issued. 10-8-55

County Barber

KANSAS

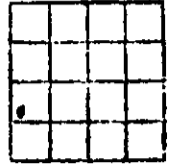

Elevation. 1422 DF

Production. 175 BOPD

CASING:

10 3/4 240'
5 1/2 4631'

Figures indicate Bottom of Formations

surface clay	35
sand & shale streaks	125
shale	175
shale & shells	240
red bed & shells	840
shale	1200
anhydrite & shale	1245
shale & shells	1500
anhydrite, shells & shale	1575
shale & shells	1700
lime & shale	1870
lime	1895
lime & shale	2015
lime	2105
lime & shale	3694
Douglas sand	3721
sand & shale	3770
K. C. lime	3810
lime	4125
lime & shale	4183
lime, shale & chert	4199
lime & shale	4472
Mississippi lime	4502
cherty lime	4557
lime	4632
Total Depth	

TOPS:	
Heebner	3561
Douglas shale	3559
Toronto	3584
Haskell	3648
Douglas sand	3690
Lansing	3768
Mississippi	4446