


### WELL PLUGGING RECORD

Give All Information Completely  
Make Required Affidavit  
Mail or Deliver Report to:  
Conservation Division  
State Corporation Commission  
211 No. Broadway  
Wichita, Kansas

Barber County. Sec. 14 Twp. 33 Rge. 11 (E) W (W)

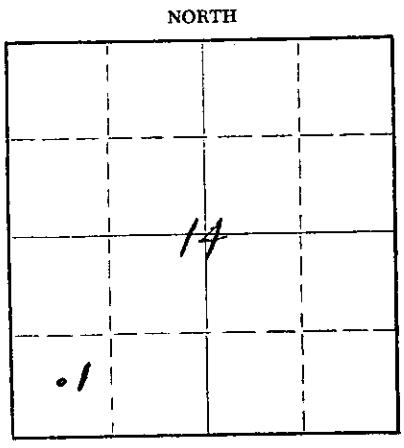

Location as "NE/CNW&SW" or footage from lines SW SW SW  
Lease Owner Sinclair Oil & Gas Company  
Lease Name John Alfred Circle Well No. 1  
Office Address Chase, Kansas  
Character of Well (completed as Oil, Gas or Dry Hole) Oil  
Date well completed 6-23-55 19  
Application for plugging filed 3-18-59 19  
Application for plugging approved 3-19-59 19  
Plugging commenced 4-28-59 19  
Plugging completed 4-2-59 19  
Reason for abandonment of well or producing formation Not profitable to operate.

If a producing well is abandoned, date of last production 3-12-59 19  
Was permission obtained from the Conservation Division or its agents before plugging was commenced? Yes

Name of Conservation Agent who supervised plugging of this well Bill Lackamp  
Producing formation Miss. Depth to top 4572 Bottom 4578 Total Depth of Well 4662 Feet  
Show depth and thickness of all water, oil and gas formations. 4572 4578

#### OIL, GAS OR WATER RECORDS

#### CASING RECORD

FORMATION	CONTENT	FROM	TO	SIZE	PUT IN	PULLED OUT
				10-3/4"	253'	none
				5-1/2"	4661	3105'

Describe in detail the manner in which the well was plugged, indicating where the mud fluid was placed and the method or methods used in introducing it into the hole. If cement or other plugs were used, state the character of same and depth placed, from \_\_\_\_\_ feet to \_\_\_\_\_ feet for each plug set.

Checked the hole to 4662' and found it open.  
Filled w/sand to 4565' and dumped 5 sacks of cement with bailer. Pulled 5 1/2" casing, cleared hole and bailed off fluid. Mudded the hole to 250', set rock bridge to 240' and dumped 25 sacks of cement. Mudded the hole to 40', set rock bridge to 30' and ran 15 sacks of cement to base of cellar.

RECEIVED  
STATE CORPORATION COMMISSION

APR 15 1959

CONSERVATION DIVISION  
Wichita

(If additional description is necessary, use BACK of this sheet)

Name of Plugging Contractor West Supply Co., Inc.  
Address Chase, Kansas

STATE OF KANSAS COUNTY OF RICE, ss.  
I, W.B. Rhees (employee or owner or operator) of the above-described

well, being first duly sworn on oath, says: That I have knowledge of the facts, statements, and matters herein contained and the log of the above-described well as filed and that the same are true and correct. So help me God.

(Signature) I. W. B. Rhees  
P.O. Box 466, Chase, Kansas (Address)

SUBSCRIBED AND SWORN TO before me this 13th day of April, 1959

My commission expires 8-13-62 Notary Public.

PLUGGING  
FILE SEC 11 T 33 R 11W  
BOOK PAGE 23 LINE 7

WELL LOG BUREAU--KANSAS GEOLOGICAL SOCIETY  
508 East Murdock, Wichita, Kansas


COPY

Company- SINCLAIR OIL & GAS COMPANY  
Farm- J. A. Circle No. 1

SEC. 14 T. 33 R. 11W  
SW SW SW

Total Depth. 4662  
Comm. 4-20-55 Comp. 5-20-55  
Shot or Treated.  
Contractor. Adkins Drlg Co., Inc.  
Issued. 6-11-55

County Barber KANSAS

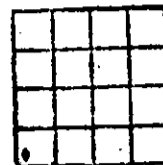

CASING:  
10 3/4" 253' cem w/200 sx  
5 1/2" 4661' cem w/250 sx

Elevation. 1133

Production. 112 bbls

Figures indicate Bottom of Formations

red rock	65
red rock, sand	185
shale	260 cement 253-260'
red bed, shale	850
shale grey	1285
anhydrite	1305
shale	1535
lime	1745
lime sandy	1905
lime, shale	2095
shale, lime	2455
shale, shells	2570
shale	3010
lime, shale	3360
shale	3574
shale, lime	3623
shale, sand	3720
shale	3764
shale, lime	3860
lime	4048
shale	4090
shale, lime	4125
lime	4355
shale, lime	4396
lime	4662
Total Depth	
Tops: Scout	
Lansing	3784
Miss. lime	4574