


R

STATE OF KANSAS
STATE CORPORATION COMMISSION

Form CP-4

Give All Information Completely
Make Required Affidavit
Mail or Deliver Report to:
Conservation Division
State Corporation Commission
212 No. Market
Wichita, Kansas 67202

WELL PLUGGING RECORD

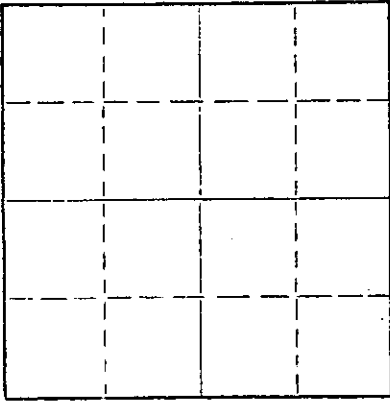

Locate well correctly on above
Section Plat

Barber County, Sec. 31 Twp. 33 Rge. 11W (E) (W)
Location as "NE/CNW/SW" or footage from lines SW NE NW
Lease Owner Clinton Oil Company
Lease Name Fitzgerald #1 Well No.
Office Address Wichita, Kansas 67202
Character of Well (completed as Oil, Gas or Dry Hole)
Date well completed 19
Application for plugging filed 19
Application for plugging approved 19
Plugging commenced 5/20/71 19
Plugging completed 5/26/71 19
Reason for abandonment of well or producing formation depleted.
If a producing well is abandoned, date of last production 19
Was permission obtained from the Conservation Division or its agents before plugging was commenced? yes

Name of Conservation Agent who supervised plugging of this well Biberstein
Producing formation Depth to top Bottom Total Depth of Well 4707 Feet
Show depth and thickness of all water, oil and gas formations.

OIL, GAS OR WATER RECORDS

CASING RECORD

| FORMATION | CONTENT | FROM | TO | SIZE | PUT IN | PULLED OUT |
|-----------|---------|------|----|--------|--------|------------|
| | | | | 8-5/8 | 258 | none |
| | | | | 5 1/2" | 4706' | 3618' |
| | | | | | | |
| | | | | | | |
| | | | | | | |
| | | | | | | |
| | | | | | | |

Describe in detail the manner in which the well was plugged, indicating where the mud fluid was placed and the method or methods used in introducing it into the hole. If cement or other plugs were used, state the character of same and depth placed, from feet to feet for each plug set.

Pumped 120 barrels water to kill gas. Ran sand to 4540',
dumped 5 sacks of cement. Shot pipe at 3775', 3705', 3612',
pulled 116 joints. Bailed fluid to 240', set rock bridge and
dumped 4 yards ready mix.

PLUGGING COMPLETE.

RECEIVED
STATE CORPORATION COMMISSION
JUN 7 1971
CONSERVATION DIVISION
Wichita, Kansas

(If additional description is necessary, use BACK of this sheet)
Name of Plugging Contractor KNIGHT CASING PULLING CO., INC.
Address CHASE, KANSAS

STATE OF KANSAS, COUNTY OF RICE, ss.
NOEL J. KNIGHT (employee of owner) or (owner or operator) of the above-described well, being first duly sworn on oath, says: That I have knowledge of the facts, statements, and matters herein contained and the log of the above-described well as filed and that the same are true and correct. So help me God.

(Signature) Noel Knight
CHASE, KANSAS
(Address)

Subscribed and sworn to before me this 27th day of May, 1971
MARGARET MELCHER
NOTARY PUBLIC
Rice County, Kansas
My Commission Expires Feb. 15, 1975
Margaret Melcher
Notary Public.



WELL LOG

COMPANY CONTINENTAL OIL COMPANY

SEC. 31 T. 33 R. 11

FARM F. E. FITZGERALD *1/2* NO. 1

LOC. SW NE NW


TOTAL DEPTH 4707'

COUNTY BARBER CO., KANSAS

COMM. 4-29-58

COMP. 5-13-58

CONTRACTOR GARVEY DRILLING COMPANY

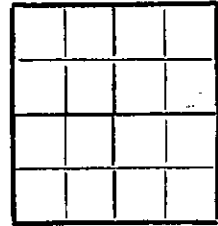

CASING 8-5/8" @ 258' W/200 sax
5-1/2 " @ 4706' W/150 sax

ELEVATION 1445' G.L.

PRODUCTION

FIGURES INDICATE BOTTOM OF FORMATIONS

| | |
|------|-----------------|
| 265 | Surface Clay |
| 934 | Red Bed & Shale |
| 1150 | Shale |
| 1320 | Shale & Salt |
| 1560 | Shale & Shells |
| 1863 | Lime & Shale |
| 1981 | Lime |
| 2743 | Lime & Shale |
| 3642 | Shale & Lime |
| 3921 | Lime & Shale |
| 4557 | Lime |
| 4609 | Lime & Chert |
| 4657 | Chert & Lime |
| 4677 | Lime & Chert |
| 4707 | Lime |

RECEIVED
STATE CORPORATION COMMISSION
MAY 10 1971
CONSERVATION DIVISION
Wichita, Kansas

State of KANSAS }
County of BARTON } ss:

I, L. J. WEBER of GARVEY DRILLING COMPANY

upon oath state that the above and foregoing is a true and correct copy of the log of the #1 FITZGERALD well

Subscribed and sworn to before me this 21st day of May 19 58

My Commission Expires: November 12, 1958

B. Brantley
NOTARY PUBLIC

SOC RFD (4) PSH FLD (2)