


STATE OF KANSAS
STATE CORPORATION COMMISSION

Give All Information Completely
Make Required Affidavit
Mail or Deliver Report to
Conservation Division
State Corporation Comm.
245 North Water
Wichita, KS 67202

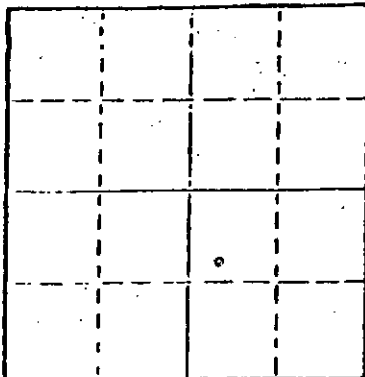

Locate well correctly on above
Section Plot

WELL PLUGGING RECORD

Barber County: Sec. 31 Twp. 33 Rge. 11 E/W
Location as "NE/CNW $\frac{1}{4}$ SW $\frac{1}{4}$ " or footage from lines
SW NW SE
Lease Owner Isern-Schultz Oil & Gas, Inc.
Lease Name Newkirk B Well No. 1
Office Address Box 486, Ellinwood, Kansas 67526
Character of Well (Completed as Oil, Gas or Dry Hole)
oil
Date Well completed Oct. 14 1957
Application for plugging filed Mar. 18 1981
Application for plugging approved 19
Plugging commenced April 8 1981
Plugging completed April 28 1981
Reason for abandonment of well or producing formation
depleted
If a producing well is abandoned, date of last production
19
Was permission obtained from the Conservation Division or
its agents before plugging was commenced? yes
Name of Conservation Agent who supervised plugging of this well Maurice Leslie
Producing formation Depth to top Bottom Total Depth of Well 4720'
Show depth and thickness of all water, oil and gas formations.

OIL, GAS OR WATER RECORDS

				CASING RECORD		
FORMATION	CONTENT	FROM	TO	SIZE	PUT IN	PULLED OUT
		0	252'	8 5/8"	252'	none
			4710'	5 1/2"	4710'	2524.36

Describe in detail the manner in which the well was plugged, indicating where the mud fluid was placed and the method or methods used in introducing it into the hold. If cement or other plugs were used, state the character of same and depth placed, from feet to feet for each plug set.

Sanded back to 4500' and dumped 5 sacks of cement.

Sun Oil Well Cementing plugged well pumping in 15 sacks of gel, 8 sacks of hulls, 10 sacks of gel and 125 sacks of cement.


(If additional description is necessary, use BACK of this sheet)
Name of Plugging Contractor PIPE RECOVERY COMPANY
Box 486, Ellinwood, Kansas 67526

STATE OF KANSAS COUNTY OF BARTON
Evelyn Roth (employee of owner) or (owner or operator)
of the above-described well, being first duly sworn on oath, says: That I have knowledge of the facts, statements, and matters herein contained and the log of the above-described well as filed and that the same are true and correct. So help me God.

(Signature) Evelyn Roth
Ellinwood, Kansas

SUBSCRIBED AND SWORN TO before me this 8th day of May, 1981

My commission expires

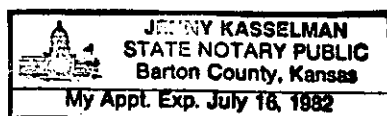

Jerry Kasselmann
Notary Public.

Wichita, Kansas

COPY

SEC. 31 T. 33 R. 11W
SW NW SE
990' SWL & 330' EWL of
SE/4.

County Barber

KANSAS

A 4x4 grid with a central dot and arrows pointing to the four adjacent cells.

Total Depth. 4720'
Comm. 9-26-57 Comp. 10-14-57
Shot or Treated.
Contractor. Graham-Michaelis Drilling Company
Issued. 3-1-58

Elevation. 1460' DF

Production. 18,000,000 CFG

CASING:

8 5/8"	252'	cem w/200	sx
5 1/2"	4710'	cem w/125	sx

Figures indicate Bottom of Formations.

sub soil, clay & sand	255
shale	1045
shale & shells	1345
broken L & Shale	1690
shale, lime shells	1840
shale & lime	2050
broken L & 'shells	2120
shale & lime	4056
lime	4198
lime & shale	4252
lime	4478
lime & shale	4594
Mississippi Chert	4612
Chert	4655
Mississippi Lime	4672
lime	4694
lime & chert	4720-RTD
Total Depth	

TOPS:	SAMPLES	SCHLUMBERGER
Heebner	3665	3678
Douglas	3712	3712
Lansing	3870	3870
Marmaton	4403	4403
Mississippian	4562	4561
Mississippian Lime	4645	4644

Perf. 4660-70' w/4 shots per ft. Squeezed
w/100 sx. cement. Resqueezed w/100 sx cement.

Perf. 4641-42' w/4 holes, Perf. 4626-41';
4598-4612'; 4584-85'; 4570-74'; & 4564-66'
w/4 holes per foot.

Acidized w/1000 gal MA, 10,000 gal crude
& 10,000# sand, & 1000# Adomite.

RECEIVED
SIPR COMMISSION
2001

MAR 20 1981

CONSERVATION DIVISION
Wichita, Kansas

K. G. S. LIBRARY