


STATE OF KANSAS  
STATE CORPORATION COMMISSION

WELL PLUGGING RECORD

Give All Information Completely  
Make Required Affidavit  
Mail or Deliver Report to  
Conservation Division  
State Corporation Comm.  
245 North Water  
Wichita, KS 67202

Barber County. Sec. 27 Twp. 33 Rge. 11 E/W  
Location as "NE/CNW $\frac{1}{4}$ /SW $\frac{1}{4}$ " or footage from lines \_\_\_\_\_  
\_\_\_\_\_ 1980' FNL & 1980' FEL  
Lease Owner SANDS DRILLING COMPANY  
Lease Name Houlton Well No. 1  
Office Address 912 Philtower Bldg., Tulsa, Okla. 74103  
Character of Well (Completed as Oil, Gas or Dry Hole) \_\_\_\_\_  
Dry Hole

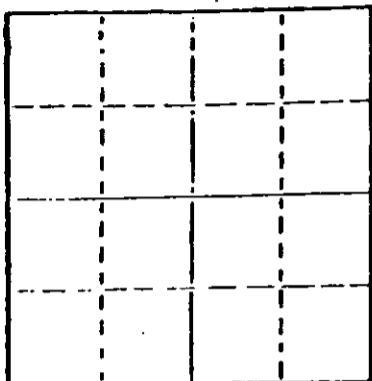

Locate well correctly on above  
Section Plot

Date Well completed 3-8 1976  
Application for plugging filed 3-8 1976  
Application for plugging approved 3-8 1976  
Plugging commenced 3-8 1976  
Plugging completed 3-8 1976  
Reason for abandonment of well or producing formation  
No commercial quantities of oil or gas encountered.  
If a producing well is abandoned, date of last production  
19

Was permission obtained from the Conservation Division or  
its agents before plugging was commenced? Yes

Name of Conservation Agent who supervised plugging of this well G. R. Biberstein  
Producing formation \_\_\_\_\_ Depth to top \_\_\_\_\_ Bottom \_\_\_\_\_ Total Depth of Well 4800  
Show depth and thickness of all water, oil and gas formations.

OIL, GAS OR WATER RECORDS

CASING RECORD

FORMATION	CONTENT	FROM	TO	SIZE	PUT IN	PULLED OUT
Surface Hole	Water	0	205	8-5/8"	194	None

Describe in detail the manner in which the well was plugged, indicating where the mud fluid  
was placed and the method or methods used in introducing it into the hold. If cement or other  
plugs were used, state the character of same and depth placed, from \_\_\_\_\_ feet to  
\_\_\_\_\_ feet for each plug set.

Fluid to 200', plug, 35 sx cement;  
Fluid to 40', plug, 15 sx cement;  
Five sacks cement in rat hole.

RECEIVED  
STATE CORPORATION COMMISSION  
MAR 22 1976  
CONSERVATION DIVISION  
WICHITA, KANSAS

(If additional description is necessary, use BACK of this sheet)

Name of Plugging Contractor D N B DRILLING, INC.  
701 First National Building  
Wichita, Kansas 67202

STATE OF KANSAS COUNTY OF \_\_\_\_\_, ss.

JAMES L. DONELSON (employee of owner) or (owner or operator) of the above-described  
well, being first duly sworn on oath, says: That I have knowledge of the facts, statements, and matters herein contained and the log of the  
above-described well as filed and that the same are true and correct. So help me God.

(Signature) James L. Donelson  
701 First Nat'l Bldg., Wichita, Kansas 67202  
(Address)

SUBSCRIBED AND SWORN TO before me this 19th day of March 19 76

My commission expires 8-25-76

Ella Priess  
Ella Priess Notary Public

Ella Priess  
STATE NOTARY PUBLIC  
Sedgwick County, Kansas  
My Com. Expires Aug. 25, 1976

DRILLERS' LOG

SANDS DRILLING COMPANY  
No. 1 Houlton  
1980' FNL & 1980' FEL, Sec. 27-33S-11W  
Barber County, Kansas

Commenced: 2-28-76  
Completed: 3-8-76

Surface Casing: 195' of 8-5/8"  
cemented w/170 sx common  
cement, 3% cc. 2-28-76

FORMATION

DEPTH

Surface Hole	0 - 205
Shale	205 - 1100
Shale & Lime Streaks	1100 - 1680
Shale & Lime	1680 - 1955
Shale	1955 - 2270
Shale & Lime	2270 - 2910
Shale	2910 - 3215
Lime & Shale	3215 - 3500
Shale & Lime	3500 - 4010
Lime	4010 - 4700
Lime & Shale	4700 - 4778
Shale & Lime	4778 - 4800 RTD

I do hereby certify that the foregoing statements are true and correct to the best of my knowledge and belief.

D N B DRILLING, INC.

*James L. Donelson*  
JAMES L. DONELSON

STATE OF KANSAS: ss:

Subscribed and sworn to before me this 19th day of March 1976.

*Ella Priess*

Ella Priess, Notary Public

