

15-007-20224-0000

STATE OF KANSAS
STATE CORPORATION COMMISSION

Form CP-4

Give All Information Completely
Make Required Affidavit
Mail or Deliver Report to:
Conservation Division
State Corporation Commission

WELL PLUGGING RECORD

P. O. Box 17027
Wichita, Kansas 67217
NORTH

Barber County, Sec 26 Twp. 30S Rge. 14W (E) (W) X

Location as "NE/CNW/SE/SW" or footage from lines SW SE SW

Lease Owner Hershberger Explorations, Inc.

Lease Name Lambert Well No. # 1

Office Address Suite 230, Garvey East, 200 W. Douglas, Wichita, KS 67202

Character of Well (completed as Oil, Gas or Dry Hole) D & A

Date well completed January 25 19 73

Application for plugging filed January 25 19 73

Application for plugging approved January 25 19 73


Plugging commenced January 25 19 73

Plugging completed January 25 19 73

Reason for abandonment of well or producing formation D & A

If a producing well is abandoned, date of last production 19

Was permission obtained from the Conservation Division or its agents before plugging was commenced? Yes

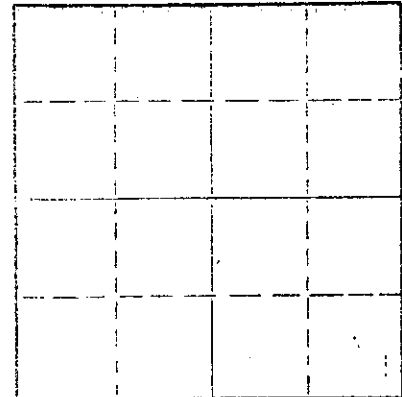

Locate well correctly on above Section Plat

Name of Conservation Agent who supervised plugging of this well G. R. Biberstein

Producing formation _____ Depth to top _____ Bottom _____ Total Depth of Well 3925 Feet

Show depth and thickness of all water, oil and gas formations.

OIL, GAS OR WATER RECORDS

CASING RECORD

FORMATION	CONTENT	FROM	TO	SIZE	PUT IN	PULLED OUT
				8-5/8	286'	-0-

Describe in detail the manner in which the well was plugged, indicating where the mud fluid was placed and the method or methods used in introducing it into the hole. If cement or other plugs were used, state the character of same and depth placed, from _____ feet to _____ feet for each plug set.

Plugged hole w/mud to 300'
1/2 sk hulls plug. 30 sx
cement-mud to 40'
1/2 sk. hulls plug. 10 sx
cement to top of csg. 2sx
in rathole.

RECEIVED
STATE CORPORATION COMMISSION
FEB 7 1973
2-7-73
CONSERVATION DIVISION
Wichita, Kansas


(If additional description is necessary, use BACK of this sheet)
Name of Plugging Contractor Red Tiger Drilling Co.
Address 1720 Wichita Plaza, Wichita, Kansas 67202

STATE OF Kansas COUNTY OF Sedgwick, ss.
Virginia K. Albert (employee of owner) or (owner or operator) of the above-described

well, being first duly sworn on oath, says: That I have knowledge of the facts, statements, and matters herein contained and the log of the above-described well as filed and that the same are true and correct. So help me God.

(Signature) Virginia K. Albert
1720 Wichita Plaza, Wichita, Kansas 67202
(Address)

Subscribed and sworn to before me this 2nd day of February, 1973

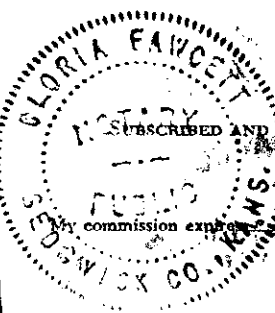

Gloria Sawcett
Notary Public.

DRILLERS LOG

No. 1 Lambert

CASING RECORD: 8-5/8" @ 286' w/275 sx cement
 COMPANY: Hershberger Explorations, Inc.
 CONTRACTOR: Red Tiger Drilling Co.
 COMMENCED: January 16, 1973
 COMPLETED: January 25, 1973
 TOTAL DEPTH: 3925'
 DESCRIPTION: Apx. SW SE SW 26-30S-14W Barber County, Kansas
 ELEVATION:

<u>FORMATION</u>	<u>FROM</u>	<u>TO</u>	<u>REMARKS</u>
Surface hole	0	1050	
Shale & Redbed	1050	1283	
Anhydrite	1283	1297	
Shale & Shells	1297	1637	
Salt	1637	1671	
Shale & Shells	1671	1785	
Shale & Lime	1785	2360	
Lime	2360	2430	
Lime & Shale	2430	2790	
Shale & Lime Streaks	2790	2980	
Shale & Lime	2980	3025	
Lime	3025	3105	
Lime & Shale	3105	3220	
Lime	3220	3380	
Lime & Shale	3380	3440	
Lime	3440	3565	
Lime & Shale	3565	3645	
Lime	3645	3730	
Lime & Shale	3730	3780	
Sandy Lime & Shale	3780	3877	
Lime	3877	3925	

RECEIVED
 STATE CORPORATION COMMISSION
 FEB 7 1973
 2-7-73
 CONSERVATION DIVISION
 Wichita, Kansas

I certify that this is a true and correct copy of the above log to the best of my knowledge.

RED TIGER DRILLING COMPANY

Virginia K. Albert
 Virginia K. Albert

Subscribed and sworn to before me this 2nd day of February, 1973.

Gloria Sawett
 Notary Public

My Commission Expires:
 October 25, 1976

