

STATE OF KANSAS
STATE CORPORATION COMMISSION


WELL PLUGGING RECORD

Give All Information Completely
Make Required Affidavit
Mail or Deliver Report to:
Conservation Division
State Corporation Commission
211 No. Broadway
Wichita, Kansas

Barber County. Sec. 28 Twp. 33S Rge. 15W (E) (W)

Location as "NE/CNW/SW" or footage from lines. C NW/4 NW/4
Lease Owner Republic Natural Gas Company
Lease Name Platt Well No. 1
Office Address Box 126, Ellinwood, Kansas
Character of Well (completed as Oil, Gas or Dry Hole) Oil
Date well completed October 5 19 56
Application for plugging filed July 17 19 57
Application for plugging approved July 19 19 57
Plugging commenced August 3 19 57
Plugging completed August 13 19 57
Reason for abandonment of well or producing formation Depleted

NORTH

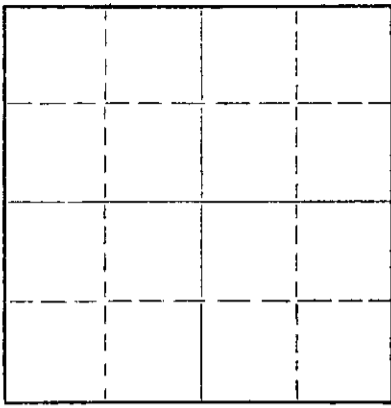

Locate well correctly on above
Section Plat

If a producing well is abandoned, date of last production July 16 19 57
Was permission obtained from the Conservation Division or its agents before plugging was commenced? Yes

Name of Conservation Agent who supervised plugging of this well M. A. Rives
Producing formation Cherokee sand Depth to top 4791 Bottom _____ Total Depth of Well 5450 Feet
Show depth and thickness of all water, oil and gas formations.

OIL, GAS OR WATER RECORDS

CASING RECORD

FORMATION	CONTENT	FROM	TO	SIZE	PUT IN	PULLED OUT
				8-5/8"	300'	None
Cherokee Sand				5-1/2"	4913'	3012'
Perforations 4791-4795						

Describe in detail the manner in which the well was plugged, indicating where the mud fluid was placed and the method or methods used in introducing it into the hole. If cement or other plugs were used, state the character of same and depth placed, from _____ feet to _____ feet for each plug set.

Measured into TD 5450'.
Plugged off bottom with sand to 4780' and dumped 5 sacks cement with bailer.
Shot 5-1/2" casing at 3012'. Mixed and circulated mud and spotted oil.
Worked and started pipe. Plugged well with mud to 300' and set permanent rock bridge.
Dumped 20 sacks cement. Filled hole with mud to 35' and mixed 10 sacks for cap on well.

(If additional description is necessary, use BACK of this sheet)

Name of Plugging Contractor J. O. Forbes d/b/a Forbes Casing Pulling Company
Address Box 221, Great Bend, Kansas

STATE OF Kansas, COUNTY OF Barton, ss.
P. B. Horst (employee of owner) or (~~owner or operator~~) of the above-described well, being first duly sworn on oath, says: That I have knowledge of the facts, statements, and matters herein contained and the log of the above-described well as filed and that the same are true and correct. So help me God.

(Signature) P. B. Horst
Box 126, Ellinwood, Kansas
(Address)

SUBSCRIBED AND SWORN TO before me this 22nd day of August, 1957

My commission expires 8-30-59

Helen Mae Berach (Notary Public)
STATE CORPORATION COMMISSION

AUG 23 1957
CONSERVATION DIVISION
Wichita, Kansas

DRILLER'S LOG

Company: Republic Natural Gas Company
Lease and Well: Platt #1
Location: C-NW/4 NW/4 Section 28-33S-15W
County: Barber
Contractor: Gabbert-Jones Drilling Company, Inc.
Commenced: 7-9-56
Completed: 8-10-56

0	-	40	Surface Clay
40	-	430	Shale and Red Bed
430	-	765	Red Bed
765	-	880	Shale
880	-	1580	Shale & Red Bed
1580	-	1640	Red Bed
1640	-	1845	Anhydrite
1845	-	1950	Shale & Shells
1950	-	2150	Lime & Shale
2150	-	2520	Lime
2520	-	2735	Lime & Shale
2735	-	2860	Shale & Shells
2860	-	3355	Lime & Shale
3355	-	3457	Broken Lime
3457	-	3545	Lime
3545	-	3675	Lime & Shale
3675	-	3750	Lime
3750	-	3850	Lime & Shale
3850	-	3936	Lime Shale and Sand
3936	-	3990	Shale & Sand
3990	-	4085	Lime & Shale
4085	-	4185	Sand
4185	-	5018	Lime
5018	-	5056	Lime & Shale
5056	-	5114	Lime
5114	-	5135	Shale w/Lime Streaks
5135	-	5141	Lime
5141	-	5200	Lime and Chert
5200	-	5226	Lime
5226	-	5259	Lime and Chert
5259	-	5291	Lime
5291	-	5348	Sand
5348	-	5384	Sand and Shale
5384	-	5406	Sand
5406	-	5450	Lime
5450			TOTAL DEPTH

Casing Record: 8-5/8" surface casing set at 300' cemented with 225 sacks.
5 1/2" production casing set at 4913' cemented with 125 sacks.

RECEIVED
STATE CORPORATION COMMISSION
JUL 18 1957
CONSERVATION DIVISION
Kansas

PLUGGING
FILE SEC 28 T 33 R 15 W
BOOK PAGE 20 LINE 20