


STATE OF KANSAS
STATE CORPORATION COMMISSION

WELL PLUGGING RECORD

Give All Information Completely
Make Required Affidavit
Mail or Deliver Report to:
Conservation Division
State Corporation Commission
212 North Market, Insurance Bldg.
Wichita, Kansas

NORTH

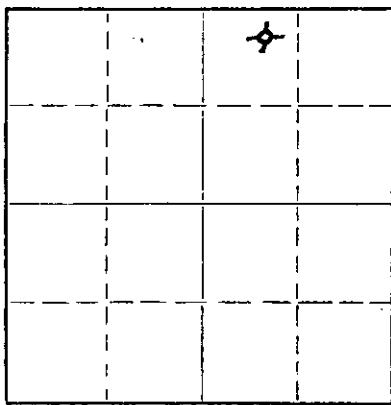

Locate well correctly on above
Section Plat

Barber County, Sec. 35 Twp. 33S Rge. 15 (E) 15 (W)
Location as "NE/CNW&SW" or footage from lines NE NW NE
Lease Owner Champlin Oil & Refining Co.
Lease Name Davis Ranch "H" Well No. 1
Office Address Box 308, Ellinwood, Kansas
Character of Well (completed as Oil, Gas or Dry Hole) Dry Hole
Date well completed December 11, 1960
Application for plugging filed December 11, 1960
Application for plugging approved December 11, 1960
Plugging commenced December 11, 1960
Plugging completed December 11, 1960
Reason for abandonment of well or producing formation

If a producing well is abandoned, date of last production 19
Was permission obtained from the Conservation Division or its agents before plugging was commenced? Yes

Name of Conservation Agent who supervised plugging of this well Fred Hampel
Producing formation _____ Depth to top _____ Bottom _____ Total Depth of Well 4960' Feet
Show depth and thickness of all water, oil and gas formations.

OIL, GAS OR WATER RECORDS

CASING RECORD

FORMATION	CONTENT	FROM	TO	SIZE	PUT IN	PULLED OUT
				13 3/8"OD	200'	None

Describe in detail the manner in which the well was plugged, indicating where the mud fluid was placed and the method or methods used in introducing it into the hole. If cement or other plugs were used, state the character of same and depth placed, from _____ feet to _____ feet for each plug set.

Filled hole with heavy rotary mud from 4960' TD to 190' and pushed in 1/3 sack of hulls and a wooden plug and pumped in 30 sacks of cement then filled hole with heavy rotary mud from top of cement to 30' and pushed in 1/3 sack of hulls and a wooden plug and pumped in 10 sacks of cement filling hole to bottom of cellar.

RECORDED
STATE CORP. COM. DIV.
DEC 21 1960
CONSERVATION DIVISION
Wichita, Kansas

(If additional description is necessary, use BACK of this sheet)
Name of Plugging Contractor M. B. Armer Drilling Co.
Address 711 Petroleum Bldg., Wichita, Kansas

STATE OF KANSAS, COUNTY OF BARTON, ss.
J. W. Meyers (employee of owner) or (OPERATOR) of the above-described well, being first duly sworn on oath, says: That I have knowledge of the facts, statements, and matters herein contained and the log of the above-described well as filed and that the same are true and correct. So help me God.
(Signature) *J. W. Meyers*
Box 308, Ellinwood, Kansas (Address)

SUBSCRIBED AND SWORN TO before me this 15th day of December, 1960.
Notary Public
My commission expires 5-22-62

Champlin Oil & Refining Co.
Davis Ranch H #1
NE $\frac{1}{4}$ NW $\frac{1}{4}$ NE $\frac{1}{4}$
Sec. 35-33S-15W
Barber County, Kansas

FORMATION LOG

Sand & Shale	0 - 30
Red Bed & Shells	30 - 640
Shale, Shells, Sand & Salt	640 - 1945
Lime	1945 - 2485
Shale & Lime	2485 - 4190
Lime	4190 - 4775
Lime & Shale	4775 - 4930
Lime	4930 - 4960 TD

RECEIVED
STATE CORPORATION COMMISSION

DEC 21 1950
CONSERVATION DIVISION
Wichita, Kansas