


WELL PLUGGING RECORD

Give All Information Completely
Make Required Affidavit
Mail or Deliver Report to:
Conservation Division
State Corporation Commission
212 No. Market
Wichita, Kansas

NORTH

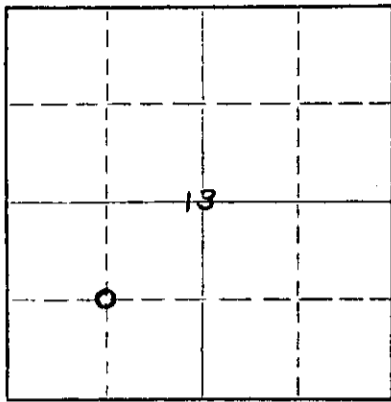

Locate well correctly on above
Section Plat

Barber County. Sec. 13 Twp. 33S Rge. xx12 (W)
Location as "NE/CNW&SW" or footage from lines C SW NE
Lease Owner Edmiston Oil Company
Lease Name Harbaugh "B" Well No. 2
Office Address 801 First Natl Bank Bldg., Wichita, Ks. 67202
Character of Well (completed as Oil, Gas or Dry Hole) dry hole
Date well completed June 29, 1972
Application for plugging filed July 6, 1972
Application for plugging approved July 5, 1972
Plugging commenced June 29, 1972
Plugging completed June 29, 1972
Reason for abandonment of well or producing formation dry hole

If a producing well is abandoned, date of last production _____ 19____
Was permission obtained from the Conservation Division or its agents before plugging was commenced? yes

Name of Conservation Agent who supervised plugging of this well G. Russel Biberstein
Producing formation _____ Depth to top _____ Bottom _____ Total Depth of Well 3695 Feet
Show depth and thickness of all water, oil and gas formations.

OIL, GAS OR WATER RECORDS

CASING RECORD

FORMATION	CONTENT	FROM	TO	SIZE	PUT IN	PULLED OUT
Surface pipe		0	315	8-5/8"	6/23/72	none

Describe in detail the manner in which the well was plugged, indicating where the mud fluid was placed and the method or methods used in introducing it into the hole. If cement or other plugs were used, state the character of same and depth placed, from _____ feet to _____ feet for each plug set.

Set bottom plug @ 350' w/40 sacks cement;
Set top plug @ 40' w/10 sacks cement.

RECEIVED
STATE CORPORATION COMMISSION
JUL 11 1972
CONSERVATION DIVISION
Wichita, Kansas

(If additional description is necessary, use BACK of this sheet)
Name of Plugging Contractor E. K. Edmiston Drilling Co., Inc.
Address 801 First Natl Bank Bldg., Wichita, Kansas 67202

STATE OF KANSAS COUNTY OF SEDGWICK
E. K. Edmiston (owner or operator) of the above-described well, being first duly sworn on oath, says: That I have knowledge of the facts, statements, and matters herein contained and the log of the above-described well as filed and that the same are true and correct. So help me God.
(Signature) [Signature]
801 First Natl Bank Bldg., Wichita, Ks.
(Address)



AND SWORN to before me this 6th day of July, 19 72
Marilyn E. Fox
Marilyn E. Fox
Notary Public.

RECEIVED
STATE CORPORATION COMMISSION


JUL 11 1972

KANSAS CORPORATION COMMISSION

CONSERVATION DIVISION
Wichita, Kansas

WELL RECORD

(Mail to Kansas Geological Survey, 4150 Monroe Street, Wichita, Kansas 67209)

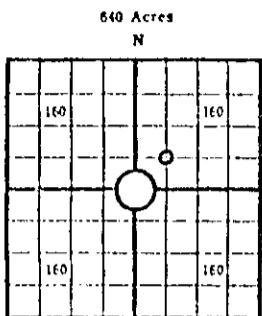

Lease Name: HARBAUGH "B" Well No. 2
 Well Located: C SW NE
Barber County SEC 13 TWP 33S RGE 12W
 Operator: Edmiston Oil Company
 Address: 801 First Natl Bank Bldg., Wichita, Ks. 67202
 Elevation: Ground 1411 D.F. 1413 K.B. 1416
 Type Well: (Oil, gas, dry hole) dry hole

Drilling Commenced: June 22, 1972 Drilling Completed: June 29, 1972
 Well Completed: June 29, 1972 Total Depth 3695
 Initial Production: _____

Casing Record

Size: 8-5/8" Set at 315 Size: _____ Set at _____
 Size: _____ Set at _____ Size: _____ Set at _____

Liner Record

Size: _____ Set from _____ To _____

Cementing

Casing Size	Sacks	Type Cement and Additives
<u>8-5/8"</u>	<u>250</u>	<u>quick drying</u>
_____	_____	_____
_____	_____	_____

Perforations

Formation	Perforated Interval and Number Shots
_____	_____
_____	_____
_____	_____

Electric Log Run (Show type log and depths covered)

Electra Radiation Accurlog 0 - 3697

(Fill in formation and related information on reverse side)

