


WELL PLUGGING RECORD

Give All Information Completely
 Make Required Affidavit

COUNTY Rush SEC. 31 TWP. 19S RGE. 19 E/W
 Location as in quarters or footage from lines:
1100' fw, 1980' fs

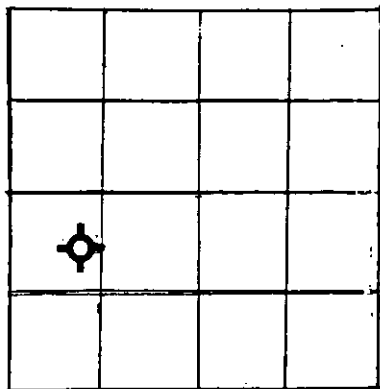

Locate Well
 correctly on above
 Section Platt.

Lease Owner Thunderbird Exploration
 Lease Name Burke Well No. 1
 Office Address 1225 17th st. #2220, Denver, Colo. 80202
 Character of Well (Completed as Oil, Gas or Dry Hole): Dry Hole
 Date Well Completed November 2, 1983
 Application for plugging filed November 2, 1983
 Plugging commenced November 2, 1983
 Plugging completed November 2, 1983
 Reason for abandonment of well or producing formation The well appeared to be non-productive
 Was permission obtained from the Conservation Division or it's Agent's before plugging was commenced? Yes

Name of Conservation Agent who supervised plugging of this well Mr. Lacey
 Producing formation none Depth to top _____ bottom _____ T.D. 1713' KB(Drilled)
 Show depth and thickness of all water, oil and gas formations.

OIL, GAS OR WATER RECORDS

Casing Record

Formation	Content	From	To	Size	Put in	Pulled Out
No productive formation drilled.				8 5/8	401.76'	None

Describe in detail the manner in which the well was plugged, indicating where the mud fluid was placed and the method or methods used in introducing it into the hold. If cement or other plugs were used, state the character of same and depth placed, from _____ feet to _____ feet for each plug set.

Cement used was 60-40 Pozmix with 3% calcium chloride and 2% gel

Heavy Mud	1713' to 1410'
50 sx Cement	1410' to 1225'
Heavy Mud	1225' to 480'
50 sx Cement	480' to 301'
Heavy Mud	301' to 40'
10 sx Cement	40' to Surface
15 sx Cement	Filled Rathole

(If additional description is necessary, use BACK of this sheet)

Name of Plugging Contractor Bergvian Drilling
Wichita, Kansas

STATE OF Colorado COUNTY OF Denver, ss.
James W. Rowland (employee of owner) or (owner or operator) of the above-described well, being first duly sworn on oath, says: That I have knowledge of the facts, statements, and matters herein contained and the log of the above-described well as filed and that the same are true and correct. So help me God.

(Signature) James W. Rowland
1225 17th St. #2220, Denver, CO 80202
 (Address)

SUBSCRIBED AND SWORN TO before me this 9th day of November, 19 83

Ann J. Walther
 Notary Public

My Commission expires: August 28, 1987
 RECEIVED 1225 17th St, 31st floor
 STATE CORPORATION
 Denver, CO 80202

NOV 14 1983
 11-14-83
 CONSERVATION DIVISION
 Wichita, Kansas