

STATE OF KANSAS
STATE CORPORATION COMMISSION

WELL PLUGGING RECORD


OR
FORMATION PLUGGING RECORD

Strike out upper line
when reporting plug-
ging off formations.

Give All Information Completely
Make Required Affidavit
Mail or Deliver Report to:
Conservation Division
State Corporation Commission
800 Bittling Building
Wichita, Kansas

Barber County, Sec. 22, Twp. 30S, Rge. 14 (E) (W)
Location as "NE $\frac{1}{4}$ NW $\frac{1}{4}$ SW $\frac{1}{4}$ " or footage from lines NW NW SW
Lease Owner Great Lakes Carbon Corporation
Lease Name Pickens Well No. 1
Office Address 501 Petroleum Building, Wichita 2, Kansas
Character of Well (completed as Oil, Gas or Dry Hole) Dry hole
Date well completed 6-21 19 49
Application for plugging filed 6-21 19 49
Application for plugging approved 6-21 19 49
Plugging commenced 6-21 19 49
Plugging completed 6-22 19 49
Reason for abandonment of well or producing formation Dry hole

NORTH

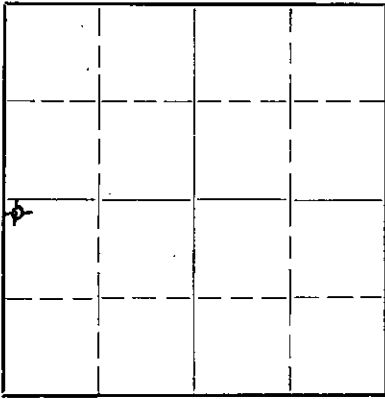

Locate well correctly on above
Section Plat

If a producing well is abandoned, date of last production 19
Was permission obtained from the Conservation Division or its agents before plugging was com-
menced? Yes

Name of Conservation Agent who supervised plugging of this well Mr. Eldon Petty for C. D. Stough
Producing formation - Depth to top - Bottom - Total Depth of Well 4756 Feet
Show depth and thickness of all water, oil and gas formations.

OIL, GAS OR WATER RECORDS

CASING RECORD

Formation	Content	From	To	Size	Put In	Pulled Out
	N O	N E				

Describe in detail the manner in which the well was plugged, indicating where the mud fluid was placed and the method or methods used in introducing it into the hold. If cement or other plugs were used, state the character of same and depth placed, from feet to feet for each plug set.

Mud 4756 to 300
Plug 300
15 sacks cement 300-255
Mud 255-35
Plug 35
Cement 35 to 6
Cellar 6 to surface

RECEIVED

CONSERVATION DIV.
6-24-49
JUN 24 1949

STATE CORPORATION
COMMISSION
KANSAS

(If additional description is necessary, use BACK of this sheet)

Correspondence regarding this well should be addressed to Great Lakes Carbon Corporation
Address 501 Petroleum Building, Wichita 2, Kansas

STATE OF KANSAS, COUNTY OF SEDGWICK, ss.


D. H. Sholtus, Dist. Prod. Supt. (employee of owner) or (owner or operator) of the above-described well, being first duly sworn on oath, says: That I have knowledge of the facts, statements, and matters herein contained and the log of the above-described well as filed and that the same are true and correct. So help me God.

(Signature) D. H. Sholtus, Dist. Prod. Supt.
501 Petroleum Bldg., Wichita, Kansas
(Address)

SUBSCRIBED AND SWORN to before me this 23rd day of June, 19 49

Asie Haun
Notary Public

My commission expires November 8, 1950

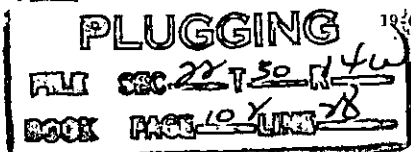

DRILLERS LOG

Great Lakes Carbon Corp.
Superior Oil Company
Coppinger & Southern

Pickens #1 C NW NW SW 22-30S-14W,
Barber County, Kansas

Total Depth: 4756'
Comm: 5-21-49
Comp: 6-23-49

Casing Record:
24 jts. 8 5/8" at 780' with
425 sacks of cement

Sand 100
Sand Shale 160
Shale & Shell 375
Red Bed 735
Anhydrite 780
Shale & Shells 1195
Shale 1640
Shale & Shells 1930
Lime 2705
Lime & Shale 3105
Shale 3140
Lime 3590
Lime & Shale 3665
Lime 3813
Lime & Shale 3891
Lime 4340

Lime & Shale 4363
Lime 4410
Lime Hard 4434
Lime 4465
Lime & Chert 4509
Lime 4520
Chert Lime 4535
Lime 4558
Chert 4636
Sand & Shale 4648
Lime 4665
Shale 4678
Lime 4686
Shale & Lime 4716
Arbuckle Lime 4731
Lime 4756

Total Depth 4756

Dry and Abandoned

Plugged well with 15 sacks cement.

STATE OF KANSAS:

COUNTY OF SEDGWICK: ss

I, the undersigned, being duly sworn, on oath, state that the above statement and log is a true and correct record and log of the well drilled at the location above described.

COPPINGER & SOUTHERN

By *[Signature]*

Subscribed and sworn to before me this 29th day of June, 1949.

JUN 29 1949
7-1-49

[Signature]
Notary Public



My Commission expires April 18, 1951.

PLUGGING
FILE SEC 22 T 30 R 14W
BOOK PAGE 102 LINE 28