

STATE CORPORATION COMMISSION OF KANSAS
OIL & GAS CONSERVATION DIVISION

API NO. 15 - 077-21,004 - 0000

County Harper

WELL COMPLETION OR RECOMPLETION FORM
ACO-1 WELL HISTORY

NW SE (location) Sec 2 Twp 31S Rge 6 West

DESCRIPTION OF WELL AND LEASE

Operator: license # 5721
name Glacier Petroleum Company, Inc.
address P.O. Box 577
City/State/Zip Emporia, Kansas 66801

1980 Ft North from Southeast Corner of Section
1980 Ft West from Southeast Corner of Section
(Note: locate well in section plat below)

Operator Contact Person J. C. Hawes
Phone 316-342-1148

Lease Name Stevens Well# 1

Field Name RUNNYM EDE TWST

Contractor: license # 5825
name Glacier Drilling Company, Inc.

Producing Formation MISS

Wellsite Geologist Chuck Kuhl
Phone 316-262-5429

Elevation: Ground 1,389' KB

Designate Type of Completion

New Well Re-Entry Workover


Oil SWD Temp Abd
 Gas Inj Delayed Comp.
 Dry Other (Core, Water Supply etc.)

If OWWO: old well info as follows:

Operator
Well Name
Comp. Date Old Total Depth

RECEIVED
STATE CORPORATION COMMISSION
OCT 09 1984
10-9-84
CONSERVATION DIVISION
Wichita, Kansas

Section Plat

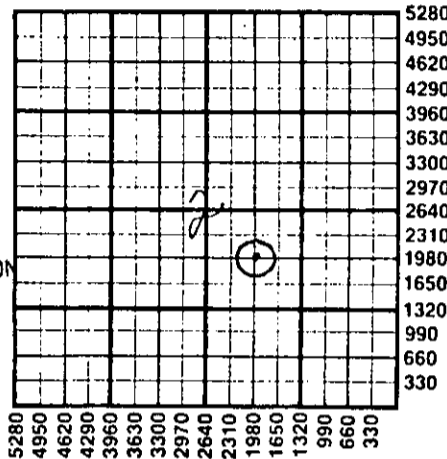

WELL HISTORY

Drilling Method: Mud Rotary Air Rotary Cable

7-07-84 7-19-84 9/19/84
Spud Date Date Reached TD Completion Date
4,340' 4,250'
Total Depth PBTD

Amount of Surface Pipe Set and Cemented at 210' feet

Multiple Stage Cementing Collar Used? Yes No

If Yes, Show Depth Set feet

If alternate 2 completion, cement circulated from feet depth to w/ SX cmt

WATER SUPPLY INFORMATION

Source of Water:

Division of Water Resources Permit #

Groundwater Ft North From Southeast Corner and
(Well) Ft. West From Southeast Corner o
Sec Twp Rge East West

Surface Water Ft North From Southeast Corner and
(Stream, Pond etc.) Ft West From Southeast Corner
Sec Twp Rge East West

Other (explain) Purchased from Harper, Kansas
(purchased from city, R.W.D.#)

Disposition of Produced Water: Disposal Repressuring

Docket #

INSTRUCTIONS: This form shall be completed in duplicate and filed with the Kansas Corporation Commission, 200 Colorado Derby Building, Wichita, Kansas 67202, within 90 days after completion or recompletion of any well. Rules 82-3-130 and 82-3-107 apply.

Information on side two of this form will be held confidential for a period of 12 months if requested in writing and submitted with the form. See rule 82-3-107 for confidentiality in excess of 12 months.

One copy of all wireline logs and drillers time log shall be attached with this form. Submit CP-4 form with all plugged wells. Submit CP-111 form with all temporarily abandoned wells.

All requirements of the statutes, rules, and regulations promulgated to regulate the oil and gas industry have been fully complied with and the statements herein are complete and correct to the best of my knowledge.

Signature [Signature]
Title Vice-President Date 10/5/84

Subscribed and sworn to before me this 5th day of October 19 84

Notary Public Ethel M. Grimwood
Date Commission Expires



K.C.C. OFFICE USE ONLY
 Letter of Confidentiality Attached
 Wireline Log Received
 Drillers Timelog Received
Distribution
 KCC SWD/Rep NGPA
 KGS Plug Other (Specify)

Form ACO-1
(This form supercedes previous forms ACO-1 & C-10)