


WELL PLUGGING RECORD

Give All Information Completely
Make Required Affidavit
Mail or Deliver Report to:
Conservation Division
State Corporation Commission
211 No. Broadway
Wichita, Kansas

Barber County, Sec. 5 Twp. 33 Rge. 10 (E) W (W)

Location as "NE/CNW/SW" or footage from lines: NE SE SW
Lease Owner Beardmore Drilling Company
Lease Name Tucker "B" Well No. 1
Office Address 827 Beacon Building, Wichita, Kansas
Character of Well (completed as Oil, Gas or Dry Hole) Dry Hole
Date well completed 9-13 19 58
Application for plugging filed 9-13 19 58
Application for plugging approved 9-13 19 58
Plugging commenced 9-13 19 58
Plugging completed 9-13 19 58
Reason for abandonment of well or producing formation Dry Hole

NORTH

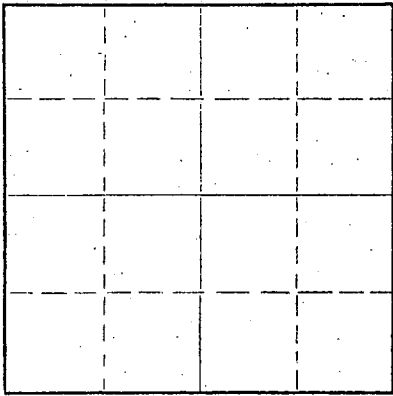

Locate well correctly on above
Section Plat

If a producing well is abandoned, date of last production _____ 19____
Was permission obtained from the Conservation Division or its agents before plugging was commenced? Yes

Name of Conservation Agent who supervised plugging of this well Bill LaKamp
Producing formation _____ Depth to top _____ Bottom _____ Total Depth of Well 4670 Feet
Show depth and thickness of all water, oil and gas formations.

OIL, GAS OR WATER RECORDS

CASING RECORD

FORMATION	CONTENT	FROM	TO	SIZE	PUT IN	PULLED OUT
Soil		0	5'			
Red Beds		5'	234'	8-5/8"	234'	0

Describe in detail the manner in which the well was plugged, indicating where the mud fluid was placed and the method or methods used in introducing it into the hole. If cement or other plugs were used, state the character of same and depth placed, from _____ feet to _____ feet for each plug set.

0 to 35' - 10 Sacks Cement
35' - Wood Plug
35' to 160' - Heavy Mud
160' to 220' - 20 Sacks Cement
220' - Wood Plug
220' to 4670' - Heavy Mud

(If additional description is necessary, use BACK of this sheet)

Name of Plugging Contractor Beardmore Drilling Company
Address 827 Beacon Building, Wichita, Kansas

STATE OF KANSAS, COUNTY OF SEDGWICK, ss.
Heber Beardmore (employee of owner) or (owner or operator) of the above-described well, being first duly sworn on oath, says: That I have knowledge of the facts, statements, and matters herein contained and the log of the above-described well as filed and that the same are true and correct. So help me God.

(Signature) Heber Beardmore
827 Beacon Building, Wichita, Kansas
(Address)

SUBSCRIBED AND SWORN TO before me this 22nd day of September 19 58.

My commission expires January 28, 1960

Leonard P. Tolle
Leonard P. Tolle

PLUGGING
FILE SEC. 5 T. 33 R. 10W
BOOK PAGE 132 LINE 12

09-26-1958
STATE Notary Public
SEP 26 1958
CONSERVATION DIVISION
Wichita, Kansas

15-007-00603-00-00

BEARDMORE-SUNRAY
#1 Tucker "B"
NE SE SW Section 5-33-10W
Barber County, Kansas

Drilled By: Beardmore Drilling Company
Drilling Commenced: 8-30-58
Drilling Completed: 9-13-58

Casing Record:

8-5/8" set at 232' with 140 sacks cement. Cement circulated. 8-30-58.

Elevations: 1570 KB - Est.
1567 DF - Est.
1564 Gr

<u>FORMATIONS</u>	<u>DEPTH</u>
Cellar	5
Red Bed	232
Red Bed and Shale	900
Shale and Lime	2300
Shale w/ Lime Streaks	2445
Shale and Lime	3758
Sand and Shale	3850
Shale and Lime	3980
Lime	4099
Lime and Shale	4142
Lime	4265
Lime and Shale	4295
Lime	4400
Lime and Shale	4570
Lime and Chert	4665
Rotary Total Depth	4670

TOPS

Heebner	3638
Douglas Sand	3758
Lansing	3840
Mississippi	4561

- DST #1 4561-4570 Shut in 20 min., open 1 hr., shut in 20 min. Recovered 30' mud. IF 15, FF 30, IBHP 1149, FBHP 331, I. Hydrostatic Pressure 2550, F. Hydrostatic Pressure 2480, Temperature 112°.
- DST #2 4565-4592 Shut in 20 min., open 1 hr., shut in 20 min., gas in 4 min., not enough to measure. Rec. 60' mud. IBHP 1240, FBHP 1120, IF 30, FF 45, I. Hydrostatic 2550, Temperature 113°.
- DST #3 4600-4640 Shut in 20 min., open 1 hr., shut in 20 min., gas in 9 min., not enough to measure. Rec. 30' mud, 180' slightly oil and gas cut mud, 60' muddy water, 60' salt water - total fluid 330'. IBHP 1630, FBHP 1525, IF 45, FF 138, I. Hydrostatic 2540.

STATE OF KANSAS)
) ss
COUNTY OF SEDGWICK)

I, the undersigned, being duly sworn on oath state that the above and within statement is a true and correct record and log of the well drilled on the location above described, to the best of my knowledge and belief.

W. Beardmore

Subscribed and sworn to before me this 22nd day of September, 1958.

My Commission Expires:
January 28, 1960

PLUGGING
FILE SEC. 5 T. 33 R. 10W
BOOK PAGE 132 LINE 12

RECEIVED
CORPORATION COMMISSION
Leonard P. Tolle
Leonard P. Tolle - Notary Public

CONSERVATION DIVISION
Wichita, Kansas

09-26-1958