


15-007-20251-00-00

STATE OF KANSAS
STATE CORPORATION COMMISSION
CONSERVATION DIVISION
P. O. BOX 17027
WICHITA, KANSAS 67217

FORM CP-4

WELL PLUGGING RECORD

Barber County, Sec 5 Twp 33 Rge 10 (E) W (W)
Location as "NE/CNW/SW" or footage from lines C SW SW
Lease Owner Robinson Oil Co.; Wichita, Kans. 67202
Lease Name Tucker Well No. #1
Office Address R. H. Garvey Bldg.; 300 W. Douglas
Character of Well (completed as Oil, Gas or Dry Hole) Gas
Date well completed January 30 1974
Application for plugging filed November 18 1974
Application for plugging approved November 19 1974
Plugging commenced December 7 1974
Plugging completed December 16 1974
Reason for abandonment of well or producing formation Non Commercial
Made to much water & to little gas
If a producing well is abandoned, date of last production May 15 1974
Was permission obtained from the Conservation Division or its agents before plugging was commenced? Yes

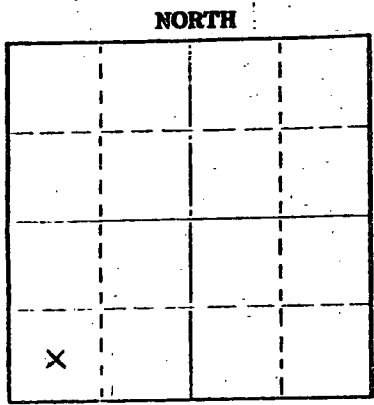

Locate well correctly on above Section Plot

Name of Conservation Agent who supervised plugging of this well Russell Biberstein
Producing formation Mississippian Depth to top 4564' Bottom 4640' Total Depth of Well 4640'
Show depth and thickness of all water, oil and gas formations.

OIL, GAS OR WATER RECORDS CASING RECORD

FORMATION	CONTENT	FROM	TO	SIZE	PUT IN	PULLED OUT
				8 5/8"	217	None
				4 1/2"	4640	3631

Describe in detail the manner in which the well was plugged, indicating where the mud fluid was placed and the method or methods used in introducing it into the hole. If cement or other plugs were used, state the character of same and depth placed, from feet to feet for each plug set.

December 7, 1974 Plugged off bottom. Dumped sand to 4400'. Mixed and dumped 4 sx of cement.
December 16, 1974 Plugged off top. Set 10' rock bridge at 420'. Filled casing and hole from 420' to base of cellar with 3000 lb. P.S.I. ready-mix concrete.

(If additional description is necessary, use BACK of this sheet)
Name of Plugging Contractor RUSS CASING PULLING, INC.
Address P. O. Box 1082; Great Bend, Kansas 67530

STATE OF Kansas COUNTY OF Sedgwick ss.
Dale M. Robinson (employee of owner) or (owner or operator) of the above-described well, being first duly sworn on oath, says: That I have knowledge of the facts, statements, and matters herein contained and the log of the above-described well as filed and that the same are true and correct. So help me God.

(Signature) Dale M. Robinson
340 R. H. Garvey Bldg., Wichita, Kansas 67202
(Address)

SUBSCRIBED AND SWORN TO before me this 8th day of January 1975

My commission expires
Esther Lamone
NOTARY PUBLIC
Sedgwick County, Kansas
Com. Expires Jan. 19, 1977

Esther Lamone
Notary Public

RECEIVED
STATE CORPORATION COMMISSION
01-09-1975
JAN 9 1975
CONSERVATION DIVISION
Wichita, Kansas

15-007-20251-00-00

ROTARY DRILLERS' LOG

OPERATOR: Hershberger Enterprises, Inc. DRILLING COMMENCED: November 9, 1973
200 West Douglas, Suite 230
Wichita, Kansas 67202

CONTRACTOR: Graves Drilling Co., Inc. DRILLING COMPLETED: November 19, 1973
505 Union Center
Wichita, Kansas 67202

CASING RECORD: 5 Jts. 217' 8-5/8" cemented with 225 sacks.
146 Jts. 4639' 4-1/2" cemented with 125 sacks.

LOCATION: Tucker No. 1
Approx. C SW SW
Section 5-33S-10W
Barber County, Kansas

0 - 218	Sod & red bed
218 - 590	Red bed
590 - 1405	Red bed, lime & shale
1405 - 1915	Lime & shale
1915 - 2115	Shale & lime
2115 - 3266	Lime & shale
3266 - 3415	Shale & lime
3415 - 3584	Lime & shale
3584 - 3670	Lime
3670 - 3860	Shale & lime
3860 - 4320	Lime
4320 - 4568	Lime & shale
4568 - 4585	Chert
4585 - 4640	Lime
4640	Rotary Total Depth

RECEIVED
STATE CORPORATION COMMISSION
NOV 19 1974
CONSERVATION DIVISION
Wichita, Kansas
11-19-1974

I hereby certify the foregoing statements to be true and correct to the best of my knowledge.

GRAVES DRILLING CO., INC.

By John Chrus
President

STATE OF KANSAS)
) ss.
SEDGWICK COUNTY)

Subscribed and sworn to before me, a Notary Public, this 28th of November, 1973.

Betty Brandt
Betty Brandt Notary Public

My commission expires: May 9, 1975