


15-007-20412-00-00

STATE OF KANSAS
STATE CORPORATION COMMISSION
CONSERVATION DIVISION
P. O. BOX 17027
WICHITA, KANSAS 67217

WELL PLUGGING RECORD

Barber County, Sec. 2 Twp. 33S Rge. (E) 10 (W)
Location as "NE/CNW/SW" or footage from lines C SE NW
Lease Owner Oil Property Management, Inc.
Lease Name Talbott Well No. 1
Office Address 300 Insurance Building - Wichita, Kansas 67202
Character of Well (completed as Oil, Gas or Dry Hole) Dry Hole
Date well completed May 6, 1976
Application for plugging filed May 6, 1976
Application for plugging approved May 6, 1976
Plugging commenced May 6, 1976
Plugging completed May 6, 1976
Reason for abandonment of well or producing formation dry hole

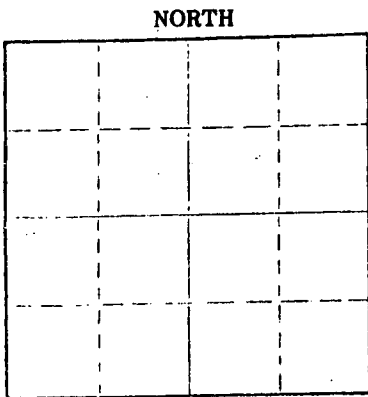

Locate well correctly on above Section Plat

If a producing well is abandoned, date of last production 19
Was permission obtained from the Conservation Division or its agents before plugging was commenced? yes

Name of Conservation Agent who supervised plugging of this well George Russell Bieberstein - Attica, Ks.
Producing formation _____ Depth to top _____ Bottom _____ Total Depth of Well 4843 feet
Show depth and thickness of all water, oil and gas formations.

OIL, GAS OR WATER RECORDS

CASING RECORD

FORMATION	CONTENT	FROM	TO	SIZE	PUT IN	PULLED OUT
	Surface					
	Casing	0	320'	8 5/8	320'	none

Describe in detail the manner in which the well was plugged, indicating where the mud fluid was placed and the method or methods used in introducing it into the hole. If cement or other plugs were used, state the character of same and depth placed, from _____ feet to _____ feet for each plug set.

Plug to 300 feet with 25 sacks cement,
plug to 40 feet with 15 sacks cement,
5 sacks cement in rat hole.
Job completed at 10:00 P.M. 5-6-76

(If additional description is necessary, use BACK of this sheet)

Name of Plugging Contractor Search Drilling Company
Address P. O. Box 18148 - Wichita, Kansas 67218

STATE OF Kansas COUNTY OF Sedgwick ss.

R. M. Wendling (employee of owner) or (owner or operator) of the above-described well, being first duly sworn on oath, says: That I have knowledge of the facts, statements, and matters herein contained and the log of the above-described well as filed and that the same are true and correct. So help me God.

(Signature) R. M. Wendling
Wichita, Kansas
(Address)

SUBSCRIBED AND SWORN TO before me this 6th day of May, 1976

My commission expires February 19, 1977

Maxine Dresser
Notary Public.

MAXINE DRESSER
NOTARY PUBLIC
SEDGWICK COUNTY, KANSAS
MY COMM. EXP. FEB. 19, 1977

RECEIVED
STATE CORPORATION COMMISSION

MAY 10 1976

05-10-1976

CONSERVATION DIVISION
Wichita, Kansas

DRILLERS LOG

TALBOTT #1

15-007 20412-00-00

CASING RECORD:

8 5/8" set at 320'
w/250 sacks cement

TOTAL DEPTH:
4843'

OPERATOR: Oil Property Management, Inc.

CONTRACTOR: Search Drilling Company

COMMENCED: April 24, 1976

COMPLETED: May 6, 1976

DESCRIPTION:

C SE NW,
Section 2-33S-10W
Barber County,
Kansas

FORMATION	FROM	TO	REMARKS
Clay and Sand	0	10	
Red Bed and Shale	10	340	
Shale	340	473	
Lime and Shale	473	1220	
Shale and Lime	1220	1615	
Lime and Shale	1615	2102	
Shale and Lime	2102	3092	
Lime and Shale	3092	3887	
Shale and Lime	3887	4005	
Lime, Shale and Chert	4005	4102	
Lime and Shale	4102	4272	
Lime	4272	4701	
Lime and Shale	4701	4778	
Lime and Shale	4778	4843	D&A

RECEIVED
STATE CORPORATION COMMISSION

MAY 10 1976

CONSERVATION DIVISION
Wichita, Kansas

05-10-1976

I certify that this is a true and correct copy of the above log to the best of my knowledge.

SEARCH DRILLING COMPANY

R. M. Wendling
R. M. Wendling

Subscribed and sworn to before me this 6th. day of May, 1976.

My commission expires:
February 19, 1977

Maxine Dressen
Maxine Dressen Notary Public

MAXINE DRESSEN
NOTARY PUBLIC
SEDGWICK COUNTY, KANSAS
MY COMM. EXP. FEB. 19, 1977