

STATE OF KANSAS
STATE CORPORATION COMMISSION

WELL PLUGGING RECORD

Give All Information Completely
Make Required Affidavit
Mail or Deliver Report to
Conservation Division
State Corporation Comm.
245 North Water
Wichita, KS 67202

Barber County. Sec. 20 Twp. 33S Rge. 10W E/W
Location as "NE/CNW $\frac{1}{4}$ SW $\frac{1}{4}$ " or footage from lines
100' SW of SW NE

Lease Owner Sun Range Resources
Lease Name Stewart C Well No. 1

Office Address 240 Page Court 220 W. Douglas Wichita, Ks.
Character of Well (Completed as Oil, Gas or Dry Hole)

D & A


Date Well completed 12-10 1977
Application for plugging filed 12-10 1977
Application for plugging approved 12-10 1977
Plugging commenced 12-10 1977
Plugging completed 12-10 1977
Reason for abandonment of well or producing formation

D & A

If a producing well is abandoned, date of last production 19

Was permission obtained from the Conservation Division or its agents before plugging was commenced? Yes

Name of Conservation Agent who supervised plugging of this well Bill Owens
Producing formation Depth to top Bottom Total Depth of Well
Show depth and thickness of all water, oil and gas formations.

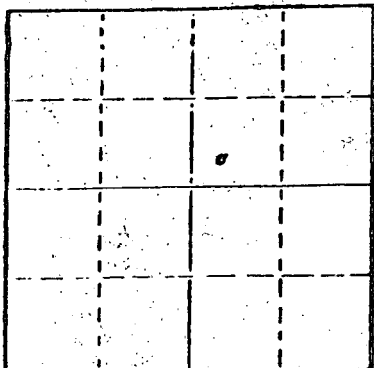

Locate well correctly on above Section Plat

OIL, GAS OR WATER RECORDS

CASING RECORD

FORMATION	CONTENT	FROM	TO	SIZE	PUT IN	PULLED OUT
Surface Pipe		-0-	349	8 5/8"	349	NONE

Describe in detail the manner in which the well was plugged, indicating where the mud fluid was placed and the method or methods used in introducing it into the hold. If cement or other plugs were used, state the character of same and depth placed, from feet to feet for each plug set.

Filled hole with heavy mud

#1 plug set @ 360' with 40 sacks cement

#2 plug set @ 40' with 12 sacks cement

#3 plug set in rat hole with 3 sacks cement

RECEIVED
STATE CORPORATION COMMISSION
DEC 16 1977
12-16-1977
CONSERVATION DIVISION
Wichita, Kansas

(If additional description is necessary, use BACK of this sheet)

Name of Plugging Contractor Sweetman Drilling, Inc.

STATE OF Kansas COUNTY OF Barton, ss.


Gary L. Hawk (employee of owner) or
of the above-described well, being first duly sworn on oath, says: That I have knowledge of the facts, statements, and matters herein contained and the log of the above-described well as filed and that the same are true and correct. So help me God.

(Signature) Gary L. Hawk
P O Box 645 Great Bend, Kansas 67530
(Address)

SUBSCRIBED AND SWORN TO before me this 15th day of December, 1977

Mary Ann Schwamborn
Notary Public.

My Commission expires 8-1-81

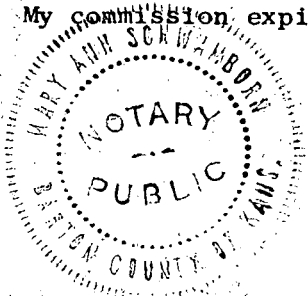

15-007-20555-01-00

WELL LOG
Stewart C-#1
100' SW of SW NE 20-33S-10W
Barber County, Kansas

Name of Operator: Sun Range Resources
240 Page Court 220 West Douglas
Wichita, Kansas 67202

Date Completed: December 10, 1977

FROM	TO	
0	1538	Red bed and shale
1538	4151	Shale and lime
4151	4184	K. C. lime
4184	4240	Shale
4240	4375	Lime
4375	4560	Lime and shale
4560	4660	Miss.
4660		Total Depth

RECEIVED
STATE CORPORATION COMMISSION

DEC 16 1977
12-16-1977
CONSERVATION DIVISION
Wichita, Kansas

STATE OF KANSAS

COUNTY OF BARTON ss

Gary L. Hawk, Secretary of Sweetman Drilling, Inc., being first duly sworn on oath says: That I have knowledge of the facts, statements and matters herein contained and the log of the above described well as filed and that the same are true and correct.

Gary L. Hawk
Gary L. Hawk

Subscribed and sworn before me this 15th day of December, 1977.

Mary Ann Schwamborn
Notary Public Barton County, Kansas

My Commission Expires 8-1-81

