


STATE OF KANSAS  
STATE CORPORATION COMMISSION

WELL PLUGGING RECORD

Give All Information Completely  
Make Required Affidavit  
Mail or Deliver Report to  
Conservation Division  
State Corporation Comm.  
245 North Water  
Wichita, KS 67202

BARBER County, Sec. 12 Twp. 33S Rge. 10 E/W  
Location as "NE/CNW $\frac{1}{4}$ /SW $\frac{1}{4}$ " or footage from lines \_\_\_\_\_  
C NE NW  
Lease Owner George R. Jones  
Lease Name #1 Fern Crow Well No. 1  
Office Address Suite 1310, 125 No. Market, Wichita, KS 67202  
Character of Well (Completed as Oil, Gas or Dry Hole) \_\_\_\_\_  
dry hole  
Date Well completed August 10 1979  
Application for plugging filed 19  
Application for plugging approved August 16 1979  
Plugging commenced August 17 1979  
Plugging completed August 17 1979  
Reason for abandonment of well or producing formation \_\_\_\_\_  
dry hole

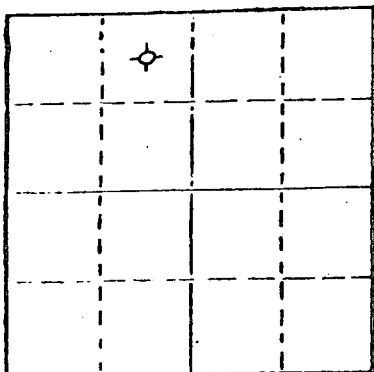

Locate well correctly on above  
Section Plat

If a producing well is abandoned, date of last production 19

Was permission obtained from the Conservation Division or its agents before plugging was commenced? Yes

Name of Conservation Agent who supervised plugging of this well William T. Owen  
Producing formation Simpson Sand Depth to top -- Bottom -- Total Depth of Well 4970'  
Show depth and thickness of all water, oil and gas formations.

OIL, GAS OR WATER RECORDS

CASING RECORD

FORMATION	CONTENT	FROM	TO	SIZE	PUT IN	PULLED OUT
		Ran 7 jts	used	28# 8-5/8"	csg set at 324'	
		cemented with	225	sx common	2% gel, 3% c.c.	
		PD 8 p.m.	7/31/79			

Describe in detail the manner in which the well was plugged, indicating where the mud fluid was placed and the method or methods used in introducing it into the hold. If cement or other plugs were used, state the character of same and depth placed, from \_\_\_\_\_ feet to \_\_\_\_\_ feet for each plug set.

Plug #1 @ 300' - 40 sx  
Plug #2 @ 40' - 125 sx  
rathole 3 sx  
PD 3:30 a.m. 8/11/79

RECEIVED  
STATE CORPORATION COMMISSION  
AUG 25 1979  
08-23-1979  
Wichita, Kansas

(If additional description is necessary, use BACK of this sheet)

Name of Plugging Contractor GABBERT-JONES, INC

STATE OF KANSAS COUNTY OF SEDGWICK  
George R. Jones (employee of owner) or (owner or operator)  
of the above-described well, being first duly sworn on oath, says: That I have knowledge of the facts, statements, and matters herein contained and the log of the above-described well as filed and that the same are true and correct. So help me God.

(Signature)

*George R. Jones*  
Suite 1310, 125 No. Market  
Wichita, Kansas 67202 (Address)

WILMA E. CLARK  
NOTARY PUBLIC  
Sedgwick County, Kansas  
My Appt. Exp. Aug. 5, 1980

22nd day of August, 1979  
*Wilma E. Clark*  
Wilma E. Clark Notary Public.

45-007-20771-00-00

AUG 16 1979

GABBERT-JONES, INC  
WICHITA, KANSAS  
DRILLERS' WELL LOG

Fern Crow #1  
NE-NW Sec 12-33S-10W  
Barber County, Kansas

Commenced: 7-31-79

Completed: 8-11-79

OPERATOR: George Jones

Depth	Formation	Remarks
From: 0 to: 60	Sand-Redbed	Ran 7 jts of 28# 8 5/8" csg
60 - 825	Redbed	set @ 324' Cemented w/
825 - 1445	Shale-Shells	225 sks 2% Gel - 3% CC
1445 - 2580	Shale	PD @ 8:00 p.m. 7-31-79
2580 - 2790	Shale-Lime	
2790 - 3230	Shale	
3230 - 3400	Shale-Lime	
3400 - 3820	Shale	
3820 - 3925	Lime	
3925 - 4155	Lime-Shale	
4155 - 4800	Lime	
4800 - 4970	Lime-Shale	
4970 - TD		DRY & ABANDONED

STATE OF KANSAS  
COUNTY OF SEDGWICK

I, the undersigned, being duly sworn on oath, state that the above Drillers' Well Log is true and correct to the best of my knowledge and belief and according to the records of this office.

GABBERT-JONES, INC

*James S. Sutton II*  
JAMES S. SUTTON II

Subscribed and sworn to before me this 15th day of August, 1979.

*Elizabeth J. Edwards*  
ELIZABETH J. EDWARDS-NOTARY PUBLIC

My Commission expires February 6, 1983.

ELIZABETH J. EDWARDS  
STATE OF KANSAS  
NOTARY PUBLIC  
SEDGWICK COUNTY

08-23-1979  
RECEIVED  
STATE COMMISSIONER  
AUG 23 1979