


15-135-209420000

FORM CP-4

STATE OF KANSAS
STATE CORPORATION COMMISSION
CONSERVATION DIVISION
P. O. BOX 17027
WICHITA, KANSAS 67217

WELL PLUGGING RECORD

Ness County. Sec. 28 Twp. 20 Rge. 22 (E) W (W)
Location as "NE/CNW&SW" or footage from lines C SE SE
Lease Owner Mack Oil Company
Lease Name Cook Well No. #1
Office Address P. O. Box 400 ; Duncan, Okla. 73533
Character of Well (completed as Oil, Gas or Dry Hole)
Date well completed 19
Application for plugging filed January 1975
Application for plugging approved January 1975
Plugging commenced January 7 1975
Plugging completed January 16 1975
Reason for abandonment of well or producing formation

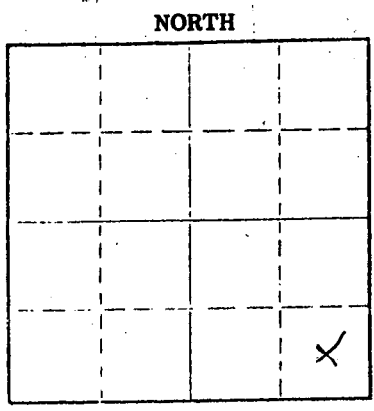

Locate well correctly on above Section Plat

If a producing well is abandoned, date of last production 19
Was permission obtained from the Conservation Division or its agents before plugging was commenced? Yes

Name of Conservation Agent who supervised plugging of this well Leo Massey
Producing formation Depth to top Bottom Total Depth of Well Feet
Show depth and thickness of all water, oil and gas formations.

OIL, GAS OR WATER RECORDS

CASING RECORD

FORMATION	CONTENT	FROM	TO	SIZE	PUT IN	PULLED OUT
				8 5/8"	370	None
				4 1/2"	4401	2397

Describe in detail the manner in which the well was plugged, indicating where the mud fluid was placed and the method or methods used in introducing it into the hole. If cement or other plugs were used, state the character of same and depth placed, from feet to feet for each plug set.

January 7, 1975 Plugged off bottom. Dumped sand to 4200'. Mixed and dumped 4 sx of cement.
January 16, 1975 Plugged off top. Halliburton Oil Well Cementing Co. mixed and pumped down 8 5/8" surface casing 25 sx of gel, 3 sx of hulls, and 115 sx of cement + 6% gel.

(If additional description is necessary, use BACK of this sheet)

Name of Plugging Contractor RUSS CASING PULLING, INC.
Address P. O. Box 1082 ; Great Bend, Kansas 67530

STATE OF OKLAHOMA COUNTY OF Stephens ss.

(employee of owner) or (owner or operator) of the above-described well, being first duly sworn on oath, says: That I have knowledge of the facts, statements, and matters herein contained and the log of the above-described well as filed and that the same are true and correct. So help me God.

(Signature) Carl A. Bentley
PO Box 400 Duncan OK 73533
(Address)

Subscribed and sworn to before me this 21st day of Feb. 1975

Josephine Bentley
Notary Public.

My commission expires 3-24-75

RECEIVED
STATE CORPORATION COMMISSION
FEB 24 1975
2-24-75
CONSERVATION DIVISION
Wichita, Kansas

WELL LOG

15-135-20942000

COMPANY Mack Oil Company

SEC. 28 T. 20S. R. 22W

FARM Cook

NO. 1

LOC. SE SE

RIG. NO. 7

TOTAL DEPTH 4420

COUNTY Ness
KANSAS

COMM. 11-13-74

COMP. 11-26-74

CONTRACTOR Rains & Williamson Oil Co., Inc.



CASING

20 10
 15 8-5/8" @ 370' w/240 sx. common, 2%
 12 6 gel, 3% cc.
 13 4 1/2" @ 4401.38 w/125 sx. 50/50 pos,
 2% gel, 18% salt

ELEVATION

PRODUCTION oil

FIGURES INDICATE BOTTOM OF FORMATIONS

Sand and Shale	370
Shale	752
Blaine	763
Shale	840
Sand	1060
Shale	1889
Shale and Lime	2192
Shale	2400
Shale and Lime	3830
Lime	4362
Chert	4415
Lime	4420
<u>Rotary Total Depth</u>	<u>4420</u>

RECEIVED
 STATE CORPORATION COMMISSION
 DEC 20 1974
 CONSERVATION DIVISION
 Wichita, Kansas

State of KANSAS
 County of SEDGWICK } ss:

I, Wilson Rains, President of the Rains & Williamson Oil Co., Inc. Company

upon oath state that the above and foregoing is a true and correct copy of the log of the Cook #1 well.

Wilson Rains
 WILSON RAINS

Subscribed and sworn to before me this 27th day of November 19 74

My Commission Expires: October 4, 1975

Juanita M. Green
 NOTARY PUBLIC
 Juanita M. Green

