

STATE OF KANSAS
STATE CORPORATION COMMISSION

WELL PLUGGING RECORD

15. B5. 22332-0000

Give All Information Completely
Make Required Affidavit
Mail or Deliver Report to
Conservation Division
State Corporation Comm.
245 North Water
Wichita, KS 67202

Ness County. Sec. 27 Twp. 20S Rge. 22 NE/W

Location as "NE/CNW $\frac{1}{2}$ SW $\frac{1}{2}$ " or footage from lines
1980' FNL & 1980' FEL

Lease Owner Woolsey Petroleum Corp.

Lease Name Vincent Narey "A" Well No. #1

Office Address 300 W. Douglas - Suite 400, Wichita, Ks.

Character of Well (Completed as Oil, Gas or Dry Hole)
Dry Hole

Date Well completed 12-11-82 19

Application for plugging filed 12-11-82 19

Application for plugging approved 12-11-82 19


Plugging commenced 12-11-82 19

Plugging completed 12-11-82 19

Reason for abandonment of well or producing formation
Commercial quantities of oil not found

If a producing well is abandoned, date of last production
19.

Was permission obtained from the Conservation Division or
its agents before plugging was commenced? Yes

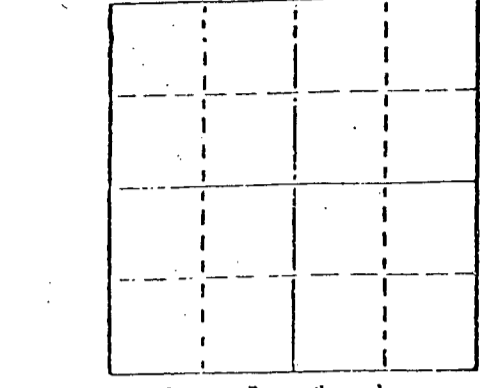

Locate well correctly on above
Section Plat

Name of Conservation Agent who supervised plugging of this well Mr. Dacon

Producing formation _____ Depth to top _____ Bottom _____ Total Depth of Well 4411'

Show depth and thickness of all water, oil and gas formations.

OIL, GAS OR WATER RECORDS

CASING RECORD

FORMATION	CONTENT	FROM	TO	SIZE	PUT IN	PULLED OUT
				8 5/8"	555'	None

Describe in detail the manner in which the well was plugged, indicating where the mud fluid
was placed and the method or methods used in introducing it into the hold. If cement or other
plugs were used, state the character of same and depth placed, from _____ feet to
_____ feet for each plug set.

- Plug @ 960' w/50 sx.
- Plug @ 590' w/50 sx.
- Plug @ 40' w/10 sx.
- Rat Hole 10 sx.

(If additional description is necessary, use BACK of this sheet)

Name of Plugging Contractor Buffalo Drilling Co., Inc.

STATE OF Kansas COUNTY OF Sedgwick, ss.
Jerald W. Rains, President of Buffalo Drilling Co., Inc. (employee of owner) or (owner or operator)
of the above-described well, being first duly sworn on oath, says: That I have knowledge of
the facts, statements, and matters herein contained and the log of the above-described well
as filed and that the same are true and correct. So help me God.

(Signature) Jerald W. Rains
435 Page Court, 220 W. Douglas, Wichita, Ks. 67202
(Address)

SUBSCRIBED AND SWORN TO before me this 14 day of December, 19 82



Juanita M. Green Notary Public.

RECEIVED
STATE CORPORATION COMMISSION

JAN 12 1983

CONSERVATION DIVISION
Wichita, Kansas