


STATE OF KANSAS  
STATE CORPORATION COMMISSION

15735-21328-0000

Give All Information Completely  
Make Required Affidavit  
Mail or Deliver Report to  
Conservation Division  
State Corporation Commission  
245 North Water  
Wichita, KS 67202

FORM CP-4

WELL PLUGGING RECORD

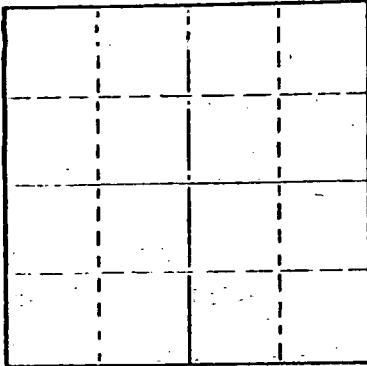

Locate well correctly on above  
Section Plat

Ness County. Sec. 27 Twp. 20 Rge. 22 (E) W (W)  
Location as "NE/CN/WX/SW" or footage from lines C SW SE  
Lease Owner North American Drilling & Exploration Co.  
Lease Name Stone Well No. 1  
Office Address Box 294, Great Bend, Kansas 67530  
Character of Well (completed as Oil, Gas or Dry Hole) Dry Hole  
Date well completed 5/30 19 77  
Application for plugging filed 5/30 19 77  
Application for plugging approved 5/30 19 77  
Plugging commenced 5/30 19 77  
Plugging completed 5/30 19 77  
Reason for abandonment of well or producing formation

If a producing well is abandoned, date of last production 19  
Was permission obtained from the Conservation Division or its agents before plugging was commenced? Yes

Name of Conservation Agent who supervised plugging of this well Gilbert Balthazor  
Producing formation Depth to top Bottom Total Depth of Well 4377 Feet  
Show depth and thickness of all water, oil and gas formations.

OIL, GAS OR WATER RECORDS

CASING RECORD

FORMATION	CONTENT	FROM	TO	SIZE	PUT IN	PULLED OUT
	Surface	0	470'	8-5/8	yes	no

Describe in detail the manner in which the well was plugged, indicating where the mud fluid was placed and the method or methods used in introducing it into the hole. If cement or other plugs were used, state the character of same and depth placed, from feet to effect for each plug set.

Bottom Plug @ 720' with 70 sacks 50-50 Poz 6% gel  
Middle Plug @ 240' with 25 sacks 50-50 Poz 6% gel  
Top and bridge @ 40' with 10 sacks 50-50 Poz, 6% gel  
5 sacks in rathole, Job complete at 12:30 P.M. 5/30/77

RECEIVED  
STATE CORPORATION COMMISSION  
JUN 10 1977  
6-10-77  
CONSERVATION DIVISION  
Wichita, Kansas

(If additional description is necessary, use BACK of this sheet)  
Name of Plugging Contractor Slawson Drilling Company, Inc.  
Address 408 One Twenty Building, Wichita, Kansas 67202


STATE OF Kansas COUNTY OF Sedgwick ss.  
James C. Remsberg (employee of owner) or (owner or operator) of the above-described well, being first duly sworn on oath, says: That I have knowledge of the facts, statements, and matters herein contained and the log of the above-described well as filed and that the same are true and correct. So help me God.

(Signature) James C. Remsberg  
408 One Twenty Building, Wichita 67202  
(Address)

SUBSCRIBED AND SWORN TO before me this 9 day of June 19 77

My commission expires January 17, 1981

Mary Lou Taylor  
Mary Lou Taylor Notary Public.

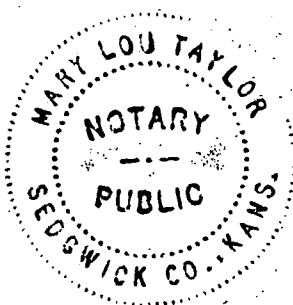

DRILLERS LOG

15-135-213280000

OPERATOR: North American Drilling & Exploration Company  
Box 294  
Great Bend, Kansas 67530

CONTRACTOR: Slawson Drilling Company, Inc.  
408 One Twenty Building  
Wichita, Kansas 67202

LEASE: Stone No. 1  
C SW3SE Sec. 27-20S-22W  
Ness County, Kansas

COMPLETED:

5/30/77

RTD: 4377'

CASING: Used 8-5/8" set at 470' with 300 sacks cement

0' to 85' Clay & sand  
85' to 473' Shale (surface hole)  
473' to 830' Shale & Shells  
830' to 1055' Dakota Sand  
1055' to 1389' Shale & Shells  
1389' to 1428' Anhydrite  
1428' to 2090' Shale & Shells  
2090' to 2425' Shale & Lime  
2425' to 2745' Lime & Shale  
2745' to 2995' Shale & Lime  
2995' to 4090' Lime & Shale  
4090' to 4377' Lime  
4377' RTD

RECEIVED  
STATE CORPORATION COMMISSION

JUN 10 1977

CONSERVATION DIVISION  
Wichita, Kansas

STATE OF KANSAS

COUNTY OF SEDGWICK

I, James C. Remsberg, of the Slawson Drilling Company, Inc. hereby state that the above and foregoing is a true and correct copy of the log of the Stone No. 1 well.

James C. Remsberg  
James C. Remsberg

Subscribed and sworn to me on this 9th day of June 1977.

Mary Lou Taylor  
Mary Lou Taylor, Notary

My commission expires January 17, 1981

