

15135-20691-0000

STATE OF KANSAS
STATE CORPORATION COMMISSION

Form CP-4

Give All Information Completely
Make Required Affidavit
Mail or Deliver Report to:
Conservation Division
State Corporation Commission
P. O. Box 17027
Wichita, Kansas 67217
NORTH

WELL PLUGGING RECORD


Ness County. Sec. 27 Twp. 20 Rge. (E) 22W(W)
Location as "NE/CNW/SW" or footage from lines 100' NW C SE NW
Lease Owner Mack Oil Company
Lease Name Reader Well No. 1
Office Address 812 Union Center, Wichita, KS 67202
Character of Well (completed as Oil, Gas or Dry Hole) dry hole
Date well completed 10-4-72 19
Application for plugging filed 10-6-72 19
Application for plugging approved 10-6-72 19
Plugging commenced 10-4-72 19
Plugging completed 10-4-72 19
Reason for abandonment of well or producing formation dry hole

If a producing well is abandoned, date of last production 19
Was permission obtained from the Conservation Division or its agents before plugging was commenced? YES

Name of Conservation Agent who supervised plugging of this well Leo F. Massey, Hays, KS

Producing formation _____ Depth to top _____ Bottom _____ Total Depth of Well 4425' Feet

Show depth and thickness of all water, oil and gas formations.

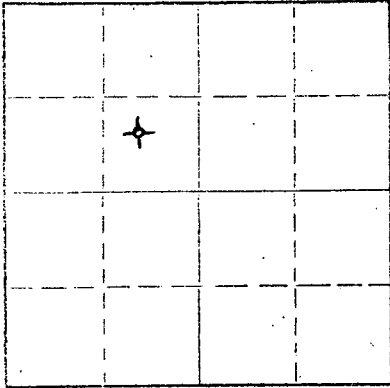

Locate well correctly on above Section Plat

OIL, GAS OR WATER RECORDS

CASING RECORD

FORMATION	CONTENT	FROM	TO	SIZE	PUT IN	PULLED OUT
				8 5/8"	360'	

Describe in detail the manner in which the well was plugged, indicating where the mud fluid was placed and the method or methods used in introducing it into the hole. If cement or other plugs were used, state the character of same and depth placed, from _____ feet to _____ feet for each plug set.

Plugged w/130 sx. 50-50 pozmix.

RECEIVED
STATE CORPORATION COMMISSION

OCT 10 1972
10-10-72

CONSERVATION DIVISION
Wichita, Kansas


(If additional description is necessary, use BACK of this sheet)
Name of Plugging Contractor Thomas Drlg. Co., Inc.
Address P. O. Box 400, Duncan, OK 73533

STATE OF Kansas COUNTY OF Sedgwick ss.
J. Corry Tinsmon (employee of owner) or (owner or operator) of the above-described

well, being first duly sworn on oath, says: That I have knowledge of the facts, statements, and matters herein contained and the log of the above-described well as filed and that the same are true and correct. So help me God.

(Signature) J. Corry Tinsmon
812 Union Center, Wichita, KS 67202
(Address)

Subscribed and sworn to before me this 6th day of October 1972
December 1, 1972
Eva Jean Burright, Notary Public.

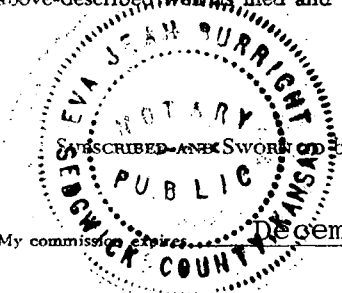

15-135-20691-0000

MACK OIL COMPANY
Duncan, Oklahoma
73533

DRILLERS WELL LOG

#1 Reader		100' NW C SE NW - Section 27-20S-22W Ness County, Kansas
Commenced R.D.	9-27-72	Elevation: 2180' K.B.; 2173' G.L.
Completed R.D.	10-4-72	Dry & Abandoned
Rotary Total Depth:	4425'	Thomas Drilling Co., Inc.-Contractor

STRATA	DEPTH
Shale & Sand	0 - 1365
Shale	1365 - 1650
Anhydrite	1650 - 1835
Shale & Lime	1835 - 2245
Lime & Shale	2245 - 2505
Lime	2505 - 4340
Lime & Chert	4340 - 4425 RTD

I hereby certify that the above is a true and correct log of said well as reflected by the daily drilling reports.

MACK OIL COMPANY

By J. Corry Tinsmon
J. Corry Tinsmon

RECEIVED
STATE CORPORATION COMMISSION

OCT 10 1972

CONSERVATION DIVISION
Wichita, Kansas

Signed and sworn to in my presence
this 6th day of October, 1972, by
J. Corry Tinsmon, representative
of Mack Oil Company.....

Eva Jean Burrig
Eva Jean Burrig, Notary Public

My Commission expires:
December 1, 1972

