

STATE OF KANSAS
STATE CORPORATION COMMISSION

WELL PLUGGING RECORD

Give All Information Completely
Make Required Affidavit
Mail or Deliver Report to
Conservation Division
State Corporation Comm.
245 North Water
Wichita, KS 67202

Ness County, Sec. 28 Twp. 20s Rge. 22w E/W
Location as "NE/CNW $\frac{1}{4}$ /SW $\frac{1}{4}$ " or footage from lines

C-SE-SW


Lease Owner Montgomery Drilling Program # 5
Lease Name McFadden Well No. 1
Office Address 235 Montgomery Street San Francisco, Calif.
Character of Well (Completed as Oil, Gas or Dry Hole) Dry Hole

Date Well completed April 20 1979
Application for plugging filed April 20 1979
Application for plugging approved April 20 1979
Plugging commenced April 21 1979
Plugging completed April 21 1979

Reason for abandonment of well or producing formation Dry Hole

If a producing well is abandoned, date of last production 19

Was permission obtained from the Conservation Division or its agents before plugging was commenced? Yes

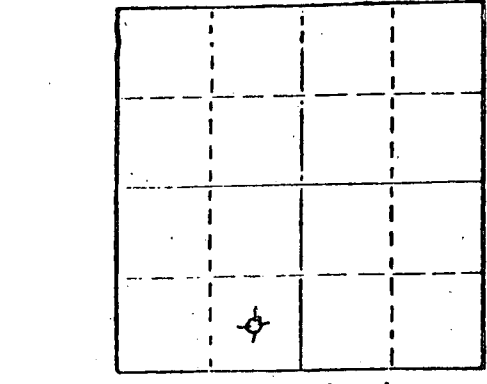

Locate well correctly on above Section Plat

Name of Conservation Agent who supervised plugging of this well Leo Massey
Producing formation _____ Depth to top _____ Bottom _____ Total Depth of Well 437'
Show depth and thickness of all water, oil and gas formations.

OIL, GAS OR WATER RECORDS

CASING RECORD

FORMATION	CONTENT	FROM	TO	SIZE	PUT IN	PULLED OUT
Surface		0'	437'	8 5/8"	437'	0'

Describe in detail the manner in which the well was plugged, indicating where the mud fluid was placed and the method or methods used in introducing it into the hold. If cement or other plugs were used, state the character of same and depth placed, from _____ feet to _____ feet for each plug set.

- 1st. plug at 500 feet with 50 sacks common cement 50-50 Poz. 6% Gel.
- 2nd. plug at 240 feet with 25 sacks common cement 50-50 Poz. 6% Gel.
- 3rd. plug at 40 feet with 10 sacks common cement 50-50 Poz. 6% Gel.

RECEIVED
STATE CORPORATION COMMISSION

MAY 11 1979
5-11-79
CONSERVATION DIVISION
KANSAS

(If additional description is necessary, use BACK of this sheet)

Name of Plugging Contractor Halliburton Services


STATE OF Kansas COUNTY OF Graham, ss.
Jerry M. Helberg (employee of owner) or (owner or operator)
of the above-described well, being first duly sworn on oath, says: That I have knowledge of the facts, statements, and matters herein contained and the log of the above-described well as filed and that the same are true and correct. So help me God.

(Signature) Jerry M. Helberg
Box 32 Morland, Ks. 67650
(Address)

SUBSCRIBED AND SWORN TO before me this 2nd day of May, 1979

James Richman
Notary Public.

My commission expires Dec. 4, 1979

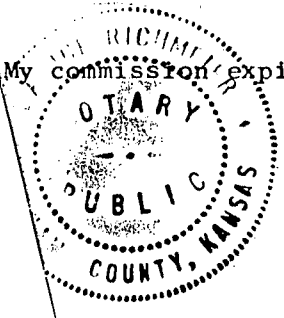

DRILLERS LOG

15-138 21588 0000

McFADDEN #1

CASING RECORD:

8 5/8" set at 437'

TOTAL DEPTH:

4376'

OPERATOR: Montgomery Drilling Program #5

CONTRACTOR: Helberg Oil Company

COMMENCED: April 9, 1979

COMPLETED: April 20, 1979

DESCRIPTION:

C SE SW
Sec. 28-20-22, Ness County, Kansas

FORMATION	FROM	TO	REMARKS
Sand	0	80	
Shale	80	85	
Sand & Shale	85	425	
Shale	425	450	
Shale	450	560	
Shale	560	1240	
Shale	1240	1445	
Shale	1445	1740	
Shale	1740	1960	
Shale	1960	1969	
Anhydrite	1969	1980	
Shale	1980	2168	
Shale	2168	2200	
Shale & lime	2200	2365	
Shale	2365	2520	
Lime & Shale	2520	2595	
Lime	2595	2693	
Shale & Lime	2693	2786	
Lime	2786	2918	
Lime & Shale	2918	3025	
Shale & Lime	3025	3132	
Lime & Shale	3132	3265	
Lime	3265	3370	
Lime	3370	3516	
Lime & Shale	3516	3685	
Lime	3685	3790	
Lime	3790	3895	
Lime & Shale	3895	4000	
Lime	4000	4065	
Lime	4065	4135	
Lime	4135	4197	
Lime	4197	4247	
Lime	4247	4320	
Lime	4320	4352	
Lime	4352	4376	
T.D.	4376		D & A

RECEIVED
STATE CORPORATION COMMISSION

MAY 11 1979

CONSERVATION DIVISION
Wichita, Kansas

I certify that the above is a true and correct copy of the log to the best of my knowledge.

HELBERG OIL COMPANY

Jerry M. Helberg
Jerry M. Helberg

Subscribed and sworn to before me this 7th day of May, 1979.

Notary Public
Notary Public

My Commission expires

Nov 4 1979

