

15-135-21150 0000


STATE OF KANSAS
STATE CORPORATION COMMISSION

Form CP-4

Give All Information Completely
Make Required Affidavit
Mail or Deliver Report to:
Conservation Division
State Corporation Commission
P. O. Box 17027
Wichita, Kansas 67217
NORTH

WELL PLUGGING RECORD

Ness County. Sec. 28 Twp. 20S Rge. (X) 22W (W)
Location as "NE/CNW/SW" or footage from lines 150' W of C NW NE
Lease Owner Mack Oil Co.
Lease Name Barricklow Well No. 2
Office Address 812 Union Center, Wichita, KS 67202
Character of Well (completed as Oil, Gas or Dry Hole) dry hole
Date well completed 1-30-76 19
Application for plugging filed 2-12-76 19
Application for plugging approved 1-30-76 19
Plugging commenced 1-30-76 19
Plugging completed 1-30-76 19
Reason for abandonment of well or producing formation dry hole
If a producing well is abandoned, date of last production 19
Was permission obtained from the Conservation Division or its agents before plugging was commenced? YES

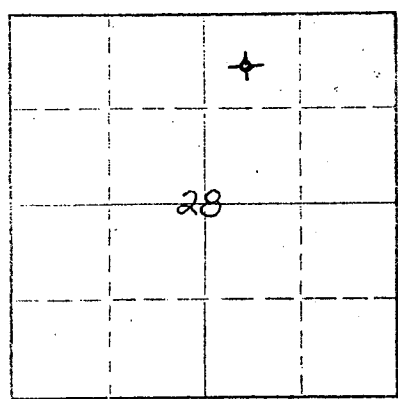

Locate well correctly on above Section Plat

Name of Conservation Agent who supervised plugging of this well G. R. Biberstein
Producing formation _____ Depth to top _____ Bottom _____ Total Depth of Well 4450 Feet
Show depth and thickness of all water, oil and gas formations.

OIL, GAS OR WATER RECORDS

CASING RECORD

FORMATION	CONTENT	FROM	TO	SIZE	PUT IN	PULLED OUT
				8 5/8"	481'	

Describe in detail the manner in which the well was plugged, indicating where the mud fluid was placed and the method or methods used in introducing it into the hole. If cement or other plugs were used, state the character of same and depth placed, from _____ feet to _____ feet for each plug set.

Plugged @ 550' w/50 sx. cement
@ 250' w/25 sx.
@ 40' w/10 sx.
2 sx. in rathole

RECEIVED
STATE CORPORATION COMMISSION

FEB 13 1976

CONSERVATION DIVISION
Wichita, Kansas

(If additional description is necessary, use BACK of this sheet)

Name of Plugging Contractor Thomas Drilling Co.
Address P. O. Box 400, Duncan, OK 73533

STATE OF Kansas COUNTY OF Sedgwick ss. Harry A. Larsh

(employee of owner) or (owner or operator) of the above-described well, being first duly sworn on oath, says: That I have knowledge of the facts, statements, and matters herein contained and the log of the above-described well as filed and that the same are true and correct. So help me God.

(Signature) Harry A. Larsh
812 Union Center, Wichita, KS 67202
(Address)



Sworn to before me this 12th day of February, 1976
My Commission Expires Jan. 8, 1978
Nancy Laggart, Notary Public.

15-135-21150 0000

RECEIVED
STATE CORPORATION COMMISSION

FEB 13 1976

MACK OIL COMPANY
Duncan, Oklahoma
73533

CONSERVATION DIVISION
Wichita, Kansas

DRILLERS WELL LOG

#2 Barricklow

150' W of C NW NE - Sec. 28-20S-22W
Ness County, Kansas
Elevation: 2187' K.B., 2178' G.L.
Contractor: Thomas Drilling Co.
Dry & Abandoned

Commenced R.D. 1-20-76
Completed R.D. 1-30-76
Rotary Total Depth: 4450'

STRATA	DEPTH
Surface Sand	398
Shale & Lime	500
Shale & Sand	898
Sand	1023
Redbed & Shale	1397
Redbed	1414
Anhydrite	1453
Shale	1826
Lime & Shale	3790
Lime	3940
Lime & Shale	4147
Lime	4285
Lime & Shale	4381
Mississippi Lime	4450 RTD

DEPTH INDICATED BOTTOM OF FORMATIONS

I hereby certify that the above is a true and correct log of said well as reflected by the daily drilling reports.

MACK OIL CO.

BY Harry A. Larsh
Harry A. Larsh

Signed and sworn to in my presence this 12th day of February, 1976, by Harry A. Larsh, representative of Mack Oil Co.

My Commission Expires Jan. 8, 1978

Nancy Laggart
Nancy Laggart
Notary Public

