


STATE OF KANSAS
STATE CORPORATION COMMISSION

Form CP-4

WELL PLUGGING RECORD

Give All Information Completely
Make Required Affidavit
Mail or Deliver Report to:
Conservation Division
State Corporation Commission
212 No. Market
Wichita, Kansas

NORTH

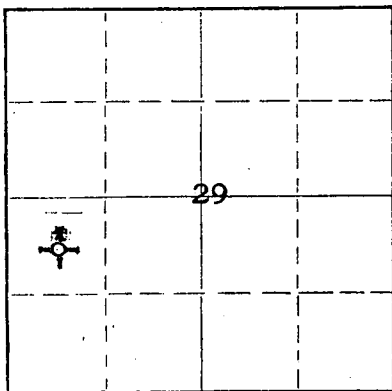

Locate well correctly on above
Section Plat

Ness County. Sec. 29 Twp. 20S Rge. 22W (W)
Location as "NE/CNW/SW" or footage from lines C NW SW
Lease Owner D. R. Lauck Oil Company, Inc.
Lease Name Hall "B" Well No. 1
Office Address 301 S. Broadway, Wichita, Kansas 67202
Character of Well (completed as Oil, Gas or Dry Hole) Dry Hole
Date well completed July 27, 19 69
Application for plugging filed July 27, 19 69
Application for plugging approved July 27, 19 69
Plugging commenced July 27, 19 69
Plugging completed July 27, 19 69
Reason for abandonment of well or producing formation Dry Hole

If a producing well is abandoned, date of last production 19
Was permission obtained from the Conservation Division or its agents before plugging was commenced? Yes

Name of Conservation Agent who supervised plugging of this well Leo Massey
Producing formation Depth to top Bottom Total Depth of Well 4385 Feet
Show depth and thickness of all water, oil and gas formations.

OIL, GAS OR WATER RECORDS

CASING RECORD

FORMATION	CONTENT	FROM	TO	SIZE	PUT IN	PULLED OUT
		0'	301'	8-5/8"	301'	None

Describe in detail the manner in which the well was plugged, indicating where the mud fluid was placed and the method or methods used in introducing it into the hole. If cement or other plugs were used, state the character of same and depth placed, from feet to feet for each plug set.

4385' to 6' 100 sacks 50-50 Pozmix Cement,
6% Gel. (6'=bottom of cellar)

RECEIVED
STATE CORPORATION COMMISSION
AUG 12 1969
CONSERVATION DIVISION
Wichita, Kansas

(If additional description is necessary, use BACK of this sheet)
Name of Plugging Contractor Lauck Drilling Company, Incorporated
Address 301 S. Broadway, Wichita, Kansas

STATE OF KANSAS, COUNTY OF SEDGWICK, ss.
John D. Knightley (employee of owner) or (owner or operator) of the above-described


well, being first duly sworn on oath, says: That I have knowledge of the facts, statements, and matters herein contained and the log of the above-described well as filed and that the same are true and correct. So help me God.

(Signature) John D. Knightley
301 S. Broadway, Wichita, Kansas (Address)

11th day of August, 19 69.

My commission expires March 12, 1971

Notary Public.

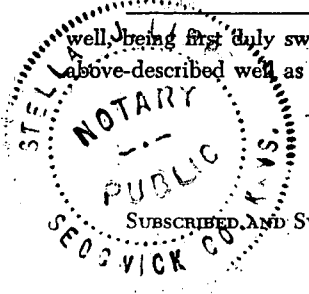

15.135.20269.0000

D. R. Lauck Oil Company, Inc.

#1 Hall "B"

C NW SW 29-20S-22W
Ness County, Kansas

Commenced: July 17, 1969

Completed: July 27, 1969

Casing Record: 301' 8-5/8" Cemented with 200 sacks Cement,
2% Calcium Chloride.

Elevation: GL 2195; DF 2197; KB 2199.

Drillers Log

Tops

Surface Clay	20
Sand	35
Shale	50
Sand	70
Shale	310
Shale & Shells	550
Red Shale	788
Blain Anhydrite	797
Red Bed	873
Sand	1082
Shale, Sand Streaks	1138
Red Bed	1445
Anhydrite	1468
Shale & Shells	2130
Lime & Shale	2625
Lime	2760
Lime & Shale	3375
Lime	3437
Lime & Shale	3695
Lime	4342
Chert	4385 RTD

	Samples
Heebner	3700-1501
Lansing	3748-1549
Ft. Scott	4257-2058
Cherokee Shale	4279-2080
Warsaw (Mississippian)	4342-2143
Osage	4376-2177
Total Depth	4385-2186
DST #1 (H) 4345-85, open 30-30-30-30	
minutes. Good blow throughout test.	
Recovered 1220' fluid: 180' watery	
mud, 240' muddy water, 800' water with	
trace oil specks on top of tool.	
ISIP 1402#. FSIP 1411#. FP 64#-274#	
and 274#-384#.	

RECEIVED
STATE CORPORATION COMMISSION
AUG 12 1969
CONSERVATION DIVISION
Wichita, Kansas

D&A