


15-135-21011-0000

STATE OF KANSAS
STATE CORPORATION COMMISSION
CONSERVATION DIVISION
P. O. BOX 17027
WICHITA, KANSAS 67217

FORM CP-4

WELL PLUGGING RECORD

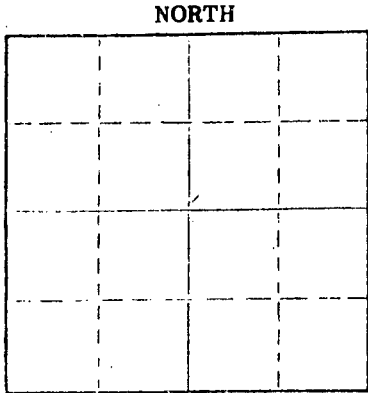

Locate well correctly on above Section Plot

Ness County. Sec. 24 Twp. 20S Rge. 22 (E) (W)
Location as "NE/CNWKSWK" or footage from lines. 150' N of SW NW
Lease Owner Rains & Williamson Oil Co., Inc.
Lease Name Bondurant "C" Well No. 1
Office Address 435 Page Court, 220 W. Douglas, KS 67202
Character of Well (completed as Oil, Gas or Dry Hole) Dry hole
Date well completed 5-5-75 19
Application for plugging filed 5-5-75 19
Application for plugging approved 5-5-75 19
Plugging commenced 5-5-75 19
Plugging completed 5-5-75 19
Reason for abandonment of well or producing formation commercial quantities of oil not found
If a producing well is abandoned, date of last production 19
Was permission obtained from the Conservation Division or its agents before plugging was commenced? yes

Name of Conservation Agent who supervised plugging of this well Leo Massey-Hays, KS
Producing formation _____ Depth to top _____ Bottom _____ Total Depth of Well 4410' Feet
Show depth and thickness of all water, oil and gas formations.

OIL, GAS OR WATER RECORDS

CASING RECORD

FORMATION	CONTENT	FROM	TO	SIZE	PUT IN	PULLED OUT
				8-5/8"	297'	

Describe in detail the manner in which the well was plugged, indicating where the mud fluid was placed and the method or methods used in introducing it into the hole. If cement or other plugs were used, state the character of same and depth placed, from _____ feet to _____ feet for each plug set.

Plug @ 500' w/50 sx
240' w/25 sx
40' w/10 sx

RECEIVED
STATE CORPORATION COMMISSION
MAY 14 1975
5-14-75
CONSERVATION DIVISION
Wichita, Kansas

(If additional description is necessary, use BACK of this sheet)
Name of Plugging Contractor Rains & Williamson Oil Co., Inc.
Address 435 Page Court, 220 W. Douglas, Wichita, KS 67202

STATE OF Kansas COUNTY OF Sedgwick, ss.
Wilson Rains, President (employee of owner) or (owner or operator) of the above-described well, being first duly sworn on oath, says: That I have knowledge of the facts, statements, and matters herein contained and the log of the above-described well as filed and that the same are true and correct. So help me God.

(Signature) Wilson Rains Wilson Rains
435 Page Court, 220 W. Douglas, Wichita, KS
(Address)

Subscribed and sworn to before me this 12th day of May, 1975 at 67202

October 4, 1975

Juanita M. Green
Juanita M. Green
Notary Public.



WELL LOG

15135-21011-0000

COMPANY Rains & Williamson Oil Co., Inc.

SEC. 24 T.20S R.22W

LOC. 150' N of SW NW

FARM Bondurant "C" NO. 1


RIG. NO. 4

TOTAL DEPTH 4410'

COUNTY Ness KANSAS

COMM. 4-24-75

COMP. 5-5-75

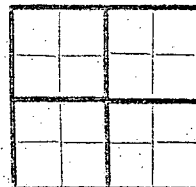

CONTRACTOR Rains & Williamson Oil Co., Inc.

CASINO

20 10
15 8-5/8" @ 297' w/175 sx common, 2% gel
12 6 3% cc
13 5

ELEVATION 2241 KB

PRODUCTION D&A

FIGURES INDICATE BOTTOM OF FORMATIONS

Post Rock, Clay, Shale	306
Shale	650
Redbed & Shale	1149
Sand, Shale, Anhydrite	1470
Anhydrite	1490
Shale & Shells	2070
Lime & Shale	2460
Shale & Lime	2964
Lime & Shale	3590
Shale & Lime	3731
Lime	4410
<u>Rotary Total Depth</u>	<u>4410</u>

RECEIVED
STATE CORPORATION COMMISSION

MAY 14 1975

CONSERVATION DIVISION
Wichita, Kansas

State of Kansas
County of Sedgwick } 59:

I, Wilson Rains, President of the Rains & Williamson Oil Company, Inc.

upon oath state that the above and foregoing is a true and correct copy of the log of the Bondurant "C" #1 well.

Wilson Rains
Wilson Rains

Subscribed and sworn to before me this 12th day of May 1975

Juanita M. Green
NOTARY PUBLIC
Juanita M. Green

My Commission Expires: October 4, 1975