


WELL PLUGGING RECORD

Give All Information Completely  
Make Required Affidavit  
Mail or Deliver Report to:  
Conservation Division  
State Corporation Commission  
211 No. Broadway  
Wichita, Kansas

BARBER County. Sec. 2 Twp. 33S Rge. 11 (#) (W)

Location as "NE/CNW/SW" or footage from lines APPROX. C NE SE  
Lease Owner PETROLEUM, INC.  
Lease Name DAVIS "H" Well No. 1  
Office Address ROUTE 2, GREAT BEND, KANSAS  
Character of Well (completed as Oil, Gas or Dry Hole) DRY HOLE  
Date well completed JUNE 29 1959  
Application for plugging filed JULY 2 1959  
Application for plugging approved JULY 8 1959  
Plugging commenced JULY 13 1959  
Plugging completed JULY 17 1959  
Reason for abandonment of well or producing formation NO PRODUCIBLE ZONES

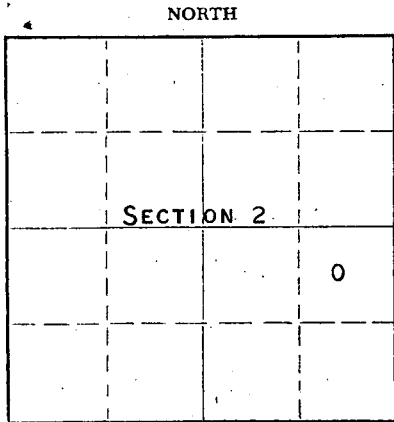

Locate well correctly on above  
Section Plat

If a producing well is abandoned, date of last production NONE 19  
Was permission obtained from the Conservation Division or its agents before plugging was commenced? YES

Name of Conservation Agent who supervised plugging of this well W. L. LACKAMP, STAFFORD, KANSAS  
Producing formation ----- Depth to top --- Bottom ----- Total Depth of Well 4607' Feet  
Show depth and thickness of all water, oil and gas formations.

OIL, GAS OR WATER RECORDS

CASING RECORD

| FORMATION         | CONTENT            | FROM  | TO    | SIZE   | PUT IN | PULLED OUT |
|-------------------|--------------------|-------|-------|--------|--------|------------|
| MISSISSIPPI CHERT | WATER & LITTLE OIL | 4514' | 4524' | 8-5/8" | 220'   | NONE       |
|                   |                    |       |       | 4-1/2" | 4604'  | 3890'      |
|                   |                    |       |       |        |        |            |
|                   |                    |       |       |        |        |            |
Describe in detail the manner in which the well was plugged, indicating where the mud fluid was placed and the method or methods used in introducing it into the hole. If cement or other plugs were used, state the character of same and depth placed, from \_\_\_\_\_ feet to \_\_\_\_\_ feet for each plug set.

(PLUGGED BACK TO 4570')

FILLED HOLE WITH CRUSHED ROCK FROM 4570'-4461', PLACED 5 SACKS OF CEMENT ON TOP OF ROCK, MUD UP TO 220' AND MADE SOLID ROCK BRIDGE. PLACED 20 SACKS OF CEMENT ON TOP OF ROCK BRIDGE. MUD UP TO 35' AND MADE SOLID ROCK BRIDGE. FILLED HOLE TO BASE OF WELL CELLAR WITH 10 SACKS OF CEMENT.

RECEIVED  
STATE CORPORATION COMMISSION

JUL 24 1959

CONSERVATION DIVISION  
WICHITA, KANSAS

(If additional description is necessary, use BACK of this sheet)

Name of Plugging Contractor MORGAN WELL PLUGGING SERVICE  
Address 102 WEST 18TH STREET, HUTCHINSON, KANSAS

STATE OF KANSAS, COUNTY OF BARTON, ss.  
DON SEARLE (employee of owner) or (#####) of the above-described well, being first duly sworn on oath, says: That I have knowledge of the facts, statements, and matters herein contained and the log of the above-described well as filed and that the same are true and correct. So help me God.

(Signature) *Don Searle*  
ROUTE 2, GREAT BEND, KANSAS (Address)

SUBSCRIBED AND SWORN TO before me this 23RD day of JULY, 1959

*Brantley*  
Notary Public.

My commission expires 11/12/62

PLUGGING  
FILE SEC 2 T. 33 R. 11W  
BOOK PAGE 42 LINE 22

# WELL LOG

COMPANY PETROLEUM, INCORPORATED

SEC. 2 T33S R. 11W

FARM DAVIS "H" NO. 1

LOC. C-NE, SE


TOTAL DEPTH 4607'

COUNTY BARBER CO., KANSAS

COMM. May 15, 1959

COMP. May 28, 1959

CONTRACTOR GARVEY DRILLING COMPANY

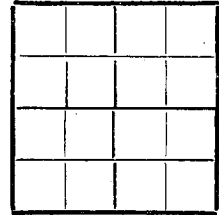

CASING 8 5/8" @ 220' W/175 sax.  
4 1/2" @ 4604' W/125 sax.

ELEVATION 1544' DF

PRODUCTION Dry & Abandoned

FIGURES INDICATE BOTTOM OF FORMATIONS

|      |                  |
|------|------------------|
| 25   | Sand & rock      |
| 220  | Red rock         |
| 285  | Shale            |
| 1040 | Red rock & shale |
| 1355 | Shale & shells   |
| 1615 | Anhydrite        |
| 1625 | Shale & shells   |
| 1835 | Shale & lime     |
| 2545 | Lime & shale     |
| 3720 | Shale & lime     |
| 3785 | Sand & shale     |
| 3910 | Shale & lime     |
| 4553 | Lime             |
| 4575 | Chert            |
| 4607 | Lime             |
| 4607 | T. D.            |

RECEIVED  
STATE CORPORATION COMMISSION

JUL 24 1959

CONSERVATION DIVISION  
Wichita, Kansas

State of KANSAS  
County of BARTON } ss:

I, VERNE A. MORRIS of GARVEY DRILLING COMPANY

upon oath state that the above and foregoing is a true and correct copy of the log of the #1 DAVIS "H" well

Subscribed and sworn to before me this 8th day of July 19 59

My Commission Expires: April 14, 1963

PLUGGING  
FILE SEC. 2 T. 33 R. 11W  
BOOK PAGE 49 LINE 27

Arthur J. Wiles  
NOTARY PUBLIC