


STATE OF KANSAS
STATE CORPORATION COMMISSION

Give All Information Completely
Make Required Affidavit
Mail or Deliver Report to:
Conservation Division
State Corporation Commission
P. O. Box 17027
Wichita, Kansas 67217
NORTH

WELL PLUGGING RECORD

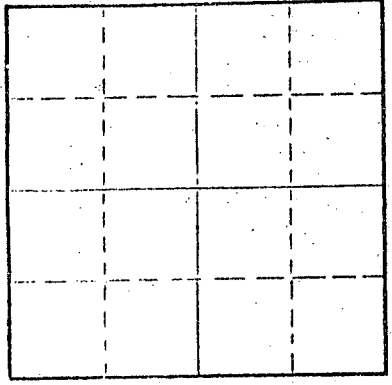

Locate well correctly on above
Section Plat

Barber County, Sec. 3 Twp. 33S Rge. 11W (E) (W)
SE SE
Location as "NE/CNW&SW" or footage from lines
Lease Owner Clarke Corporation
Lease Name Wortman Well No. B-1
Office Address Box 187, Medicine Lodge, Kansas 67104
Character of Well (completed as Oil, Gas or Dry Hole) Gas
Date well completed _____ 19____
Application for plugging filed April 17, 19 75
Application for plugging approved April 19, 19 75
Plugging commenced April 19, 19 75
Plugging completed May 1, 19 75
Reason for abandonment of well or producing formation Not productive
If a producing well is abandoned, date of last production April 17, 19 75
Was permission obtained from the Conservation Division or its agents before plugging was commenced? Yes

Name of Conservation Agent who supervised plugging of this well Russell Biberstien
Producing formation Missip. Depth to top _____ Bottom _____ Total Depth of Well 4601 Feet
Show depth and thickness of all water, oil and gas formations.

OIL, GAS OR WATER RECORDS

CASING RECORD

FORMATION	CONTENT	FROM	TO	SIZE	PUT IN	PULLED OUT
				8 5/8	293	None
				4 1/2	4600	3878

Describe in detail the manner in which the well was plugged, indicating where the mud fluid was placed and the method or methods used in introducing it into the hole. If cement or other plugs were used, state the character of same and depth placed, from _____ feet to _____ feet for each plug set.

Sand from 4566' to 4490'
4 sacks cement from 4490' to 4450'
Ripped pipe at 4000' and 3878'
Wooden bridge at 200'
Rock from 200' to 190'
3 yards of ready mix to surface.

RECEIVED
STATE CORPORATION COMMISSION
MAY 13 1975
CONSERVATION DIVISION
Wichita, Kansas

(If additional description is necessary, use BACK of this sheet)
Name of Plugging Contractor Clarke Corporation
Address Box 187, Medicine Lodge, Kansas 67104

STATE OF Kansas, COUNTY OF Barber, ss.
Elmer Margenstern (employee of owner) or (owner or operator) of the above-described well, being first duly sworn on oath, says: That I have knowledge of the facts, statements, and matters herein contained and the log of the above-described well as filed and that the same are true and correct. So help me God.

(Signature) Elmer Margenstern
Medicine Lodge, Kansas
(Address)

SUBSCRIBED AND SWORN to before me this 12th day of May, 19 75

My commission expires April 4, 1978

Jessie Hamilton
Notary Public.