


STATE OF KANSAS
STATE CORPORATION COMMISSION

WELL PLUGGING RECORD

Give All Information Completely
Make Required Affidavit
Mail or Deliver Report to:
Conservation Division
State Corporation Commission
212 North Market, Insurance Bldg.
Wichita, Kansas

NORTH

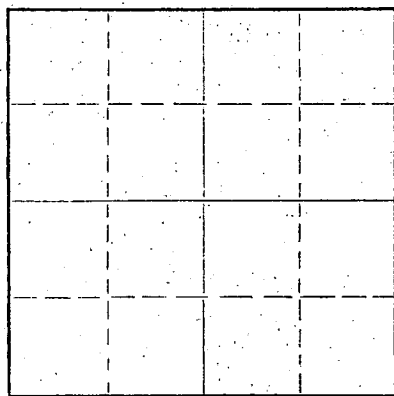

Locate well correctly on above
Section Plat

Barber County. Sec. 5 Twp. 33 Rge. 11 (E) W (W)
Location as "NE/CNW/SW" or footage from lines SE SE NE
Lease Owner O.A. Sutton Oil Properties & Investments
Lease Name Gray #1 Well No. _____
Office Address Wichita, Kansas
Character of Well (completed as Oil, Gas or Dry Hole) _____
Date well completed _____ 19____
Application for plugging filed _____ 19____
Application for plugging approved _____ 19____
Plugging commenced 3-2-59 _____ 19____
Plugging completed 3-4-59 _____ 19____
Reason for abandonment of well or producing formation _____

If a producing well is abandoned, date of last production _____ 19____
Was permission obtained from the Conservation Division or its agents before plugging was commenced? yes

Name of Conservation Agent who supervised plugging of this well Bill Lackamp
Producing formation _____ Depth to top _____ Bottom _____ Total Depth of Well 3745 Feet
Show depth and thickness of all water, oil and gas formations.

OIL, GAS OR WATER RECORDS

CASING RECORD

FORMATION	CONTENT	FROM	TO	SIZE	PUT IN	PULLED OUT
				8-5/8"	247'	none
				5-1/2"	3743'	3045'

Describe in detail the manner in which the well was plugged, indicating where the mud fluid was placed and the method or methods used in introducing it into the hole. If cement or other plugs were used, state the character of same and depth placed, from _____ feet to _____ feet for each plug set.

Checked the hole to 3075' and found it open.
Filled w/sand to 3660' and dumped 5 sacks of
cement with dump bailer. Pulled 5 1/2" casing,
cleared hole and mudded the hole to 225', set
rock bridge to 215' and dumped 20 sacks of
cement. Mudded the hole to 40', set rock
bridge to 30' and ran 10 sacks of cement to
base of cellar.

PLUGGING COMPLETED

(If additional description is necessary, use BACK of this sheet)
Name of Plugging Contractor West Supply Co., Inc.
Address Chase, Kansas

STATE OF KANSAS COUNTY OF RICE, ss.
I, Noel J. Knight (employee of owner) or (owner or operator) of the above-described well, being first duly sworn on oath, says: That I have knowledge of the facts, statements, and matters herein contained and the log of the above-described well as filed and that the same are true and correct. So help me God.

(Signature) Noel J. Knight
Chase, Kansas
(Address)

SUBSCRIBED AND SWORN TO before me this 6th day of March, 19 59

My commission expires 9-27-62

Thomas V. Lopez
Notary Public.

RECEIVED
STATE CORPORATION COMMISSION

MAR 19 1959

CONSERVATION DIVISION
Wichita, Kansas

PLUGGING
FILE SEC 5 T 33 R 11 W
BOOK PAGE 18 LINE 40

Well Log SE SE NE
 Gray # 1 Sec 5-33S-11W
 Barber County, Kansas

Crany Record

0 - 65	Red Bed	8 1/2' - 247' - CC
65 - 245	Red Bed, Shells & Gyp.	
245 - 1400	Shale & Shells	5 1/2' - 3743' - 100' ss
1400-1475	Salt	
1475 - 1575	Shale & Lime	
1575 - 1745	Lime & Shale (Fort Riley)	
1745 - 2110	Lime & Shale	
2110 - 2170	Lime	
2170 - 2940	Shale & Lime	
2940 - 3050	Lime & Shale	
3050 - 3130	Lime	
3130 - 3200	Lime & Shale	
3200 - 3245	Lime	
3245 - 3590	Lime & Shale	
3590 - 3664	Lime	
3664 - 3680	Sand	
3680 - 3695	Douglas	
3695 - 3732	Sand	
3732 - 3745	Lime - TD	

State of Kansas
 County of Barton ss

Dick B. Evans, accountant for A. L. Jackson Drilling Co., being first duly sworn on oath, says: That I have knowledge of the facts, statements, and matters herein contained and the log of the above described well as filed and that the same are true and correct.

Dick B. Evans
 Dick B. Evans
 Box 194
 Great Bend, Kansas

Subscribed and sworn to before me this 22 day of April, 1955.

Vigil

My Commission Expires April 27, 1957.

PLUGGING
 FILE SEC 5 T 33 R 11 W
 BOOK PAGE 18 LINE 40

