

STATE OF KANSAS
STATE CORPORATION COMMISSION


WELL PLUGGING RECORD

Give All Information Completely
Make Required Affidavit
Mail or Deliver Report to:
Conservation Division
State Corporation Commission
800 Biting Building
Wichita, Kansas

Barber County, Sec. 5 Twp. 33 Rge. 11 (NW) W (W)

Location as "NE/CNW/SW" or footage from lines NE SE NE
Lease Owner PETROLEUM, INC.
Lease Name GRAY Well No. 1
Office Address Rural Route 2, Great Bend, Kansas
Character of Well (completed as Oil, Gas or Dry Hole) Dry hole
Date well completed September 24 19 56
Application for plugging filed September 24 19 56
Application for plugging approved September 23 19 56
Plugging commenced September 23 19 56
Plugging completed September 24 19 56
Reason for abandonment of well or producing formation No producible zone

NORTH

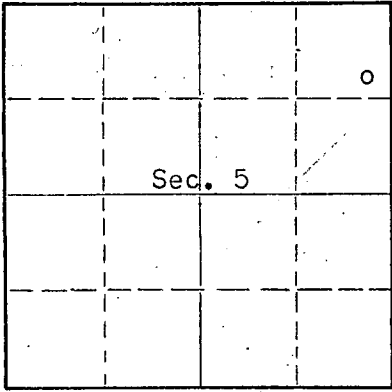

Locate well correctly on above
Section Plat

If a producing well is abandoned, date of last production None 19
Was permission obtained from the Conservation Division or its agents before plugging was commenced? yes

Name of Conservation Agent who supervised plugging of this well M. A. Rives Pratt, Kansas
Producing formation ----- Depth to top --- Bottom ----- Total Depth of Well 4510 Feet
Show depth and thickness of all water, oil and gas formations.

OIL, GAS OR WATER RECORDS

CASING RECORD

FORMATION	CONTENT	FROM	TO	SIZE	PUT IN	PULLED OUT
				8-5/8"	257'	None

Describe in detail the manner in which the well was plugged, indicating where the mud fluid was placed and the method or methods used in introducing it into the hole. If cement or other plugs were used, state the character of same and depth placed, from _____ feet to _____ feet for each plug set.

Mud up with heavy mud to 250' pushed down 1/4 sack hulls to 250' followed by wooden plug. Placed 20 sacks cement through drill pipe onto plug. Mudded up to 35' and place 1/4 sack hulls at 35' followed by wooden plug and 10 sacks cement to base of well ~~xxxxx~~ cellar.

Stamp: OCT 24 1956
CONSERVATION DIVISION
WICHITA, KANSAS

(If additional description is necessary, use BACK of this sheet)
Name of Plugging Contractor Garvey Drilling Company
Address Rural Route #2, Great Bend, Kansas

STATE OF KANSAS, COUNTY OF BARTON, ss.
DON SEARLE (employee of owner) or ~~(owner or operator)~~ of the above-described well, being first duly sworn on oath, says: That I have knowledge of the facts, statements, and matters herein contained and the log of the above-described well as filed and that the same are true and correct. So help me God.

(Signature) Don Searle
RURAL ROUTE 2, GREAT BEND, KANSAS
(Address)

SUBSCRIBED AND SWORN to before me this 2nd day of October, 19 56
My commission expires July 11, 1960
Notary Public.

PLUGGING
FILE SEC 5 T 33 R 11 W
BOOK PAGE 102 LINE 8

WELL LOG

COMPANY PETROLEUM, INCORPORATED

SEC. 5 T. 33S. R. 11W

FARM Gray NO. 1


LOC. NE, SE, NE

TOTAL DEPTH 4510'

COUNTY Barber Co., Kansas

COMM. September 10, 1956 COMP. September 24, 1956

CONTRACTOR GARVEY DRILLING COMPANY

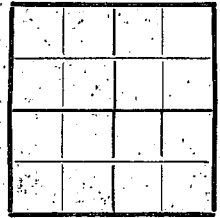

CASING 8 5/8" @ 257' W/175 sax.

ELEVATION 1438' DF

PRODUCTION D & A

FIGURES INDICATE BOTTOM OF FORMATIONS

620	Red bed & shale
1745	Shale & shells
3906	Lime & shale
3967	Lime
4067	Lime & shale
4100	Lime
4144	Lime & shale
4356	Lime
4389	Lime & shale
4502	Lime & chert
4510	Lime
4510	T. D.

RECEIVED
 STATE OF KANSAS COMMISSION
 OCT 31 1956
 RECONSTRUCTION DIVISION
 Wichita, Kansas

State of Kansas

County of Barton

PLUGGING
 FILE SEC. 5 T. 33 R. 11W
 BOOK PAGE 102 LINE 8

I, Verne A. Morris of Garvey Drilling Co.

upon oath state that the above and foregoing is a true and correct copy of the log of the Gray #1 well

Verne A. Morris

Subscribed and sworn to before me this 1st day of October 19 56

My Commission Expires: July 11, 1960

Jed J. Brown
NOTARY PUBLIC